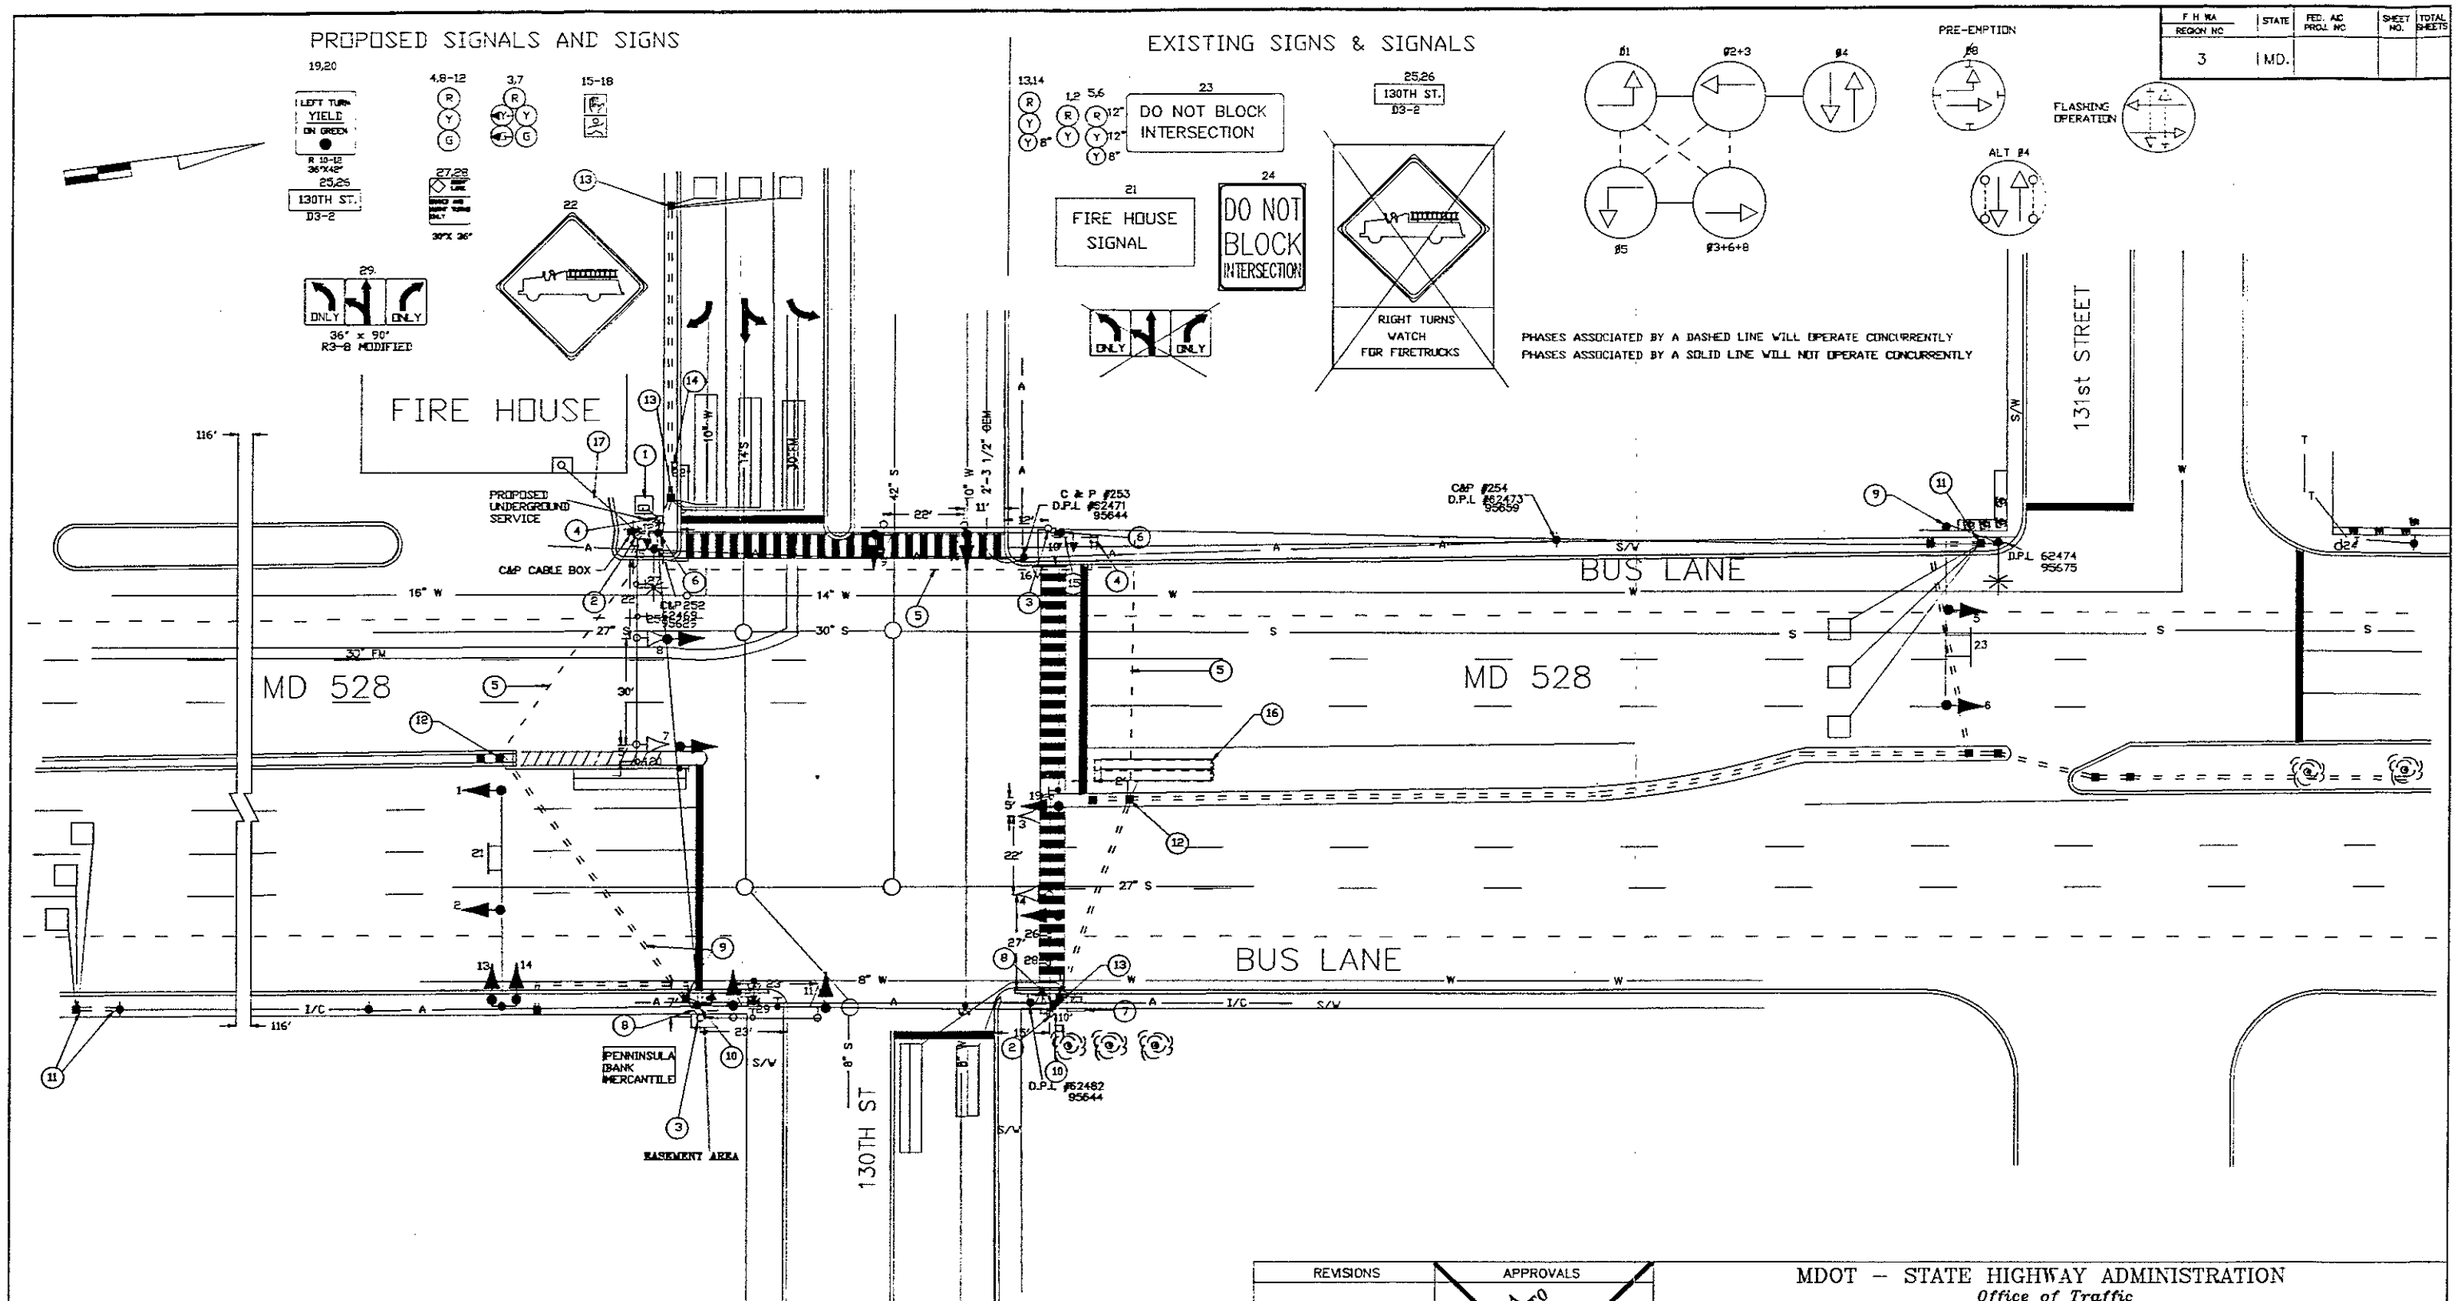

F H WA REGION NO	STATE	FED. AID PROJ. NO	SHEET NO.	TOTAL SHEETS
3	MD.			

UTILITY LEGEND

- G — G — GAS MAIN
- W — W — WATER MAIN
- S — S — SEWER MAIN
- E — E — ELECTRIC CABLES
- A — A — AERIAL CABLES
- T — T — TELEPHONE CABLES

REVISIONS	APPROVALS
(G) 11/90 RECONSTRUCT TRAFFIC SIGNAL	NOTE: AS A THIS IS A REVISION TO T.S.-1433E
(F) ASBUILT INSTALL I.C.B AT 131st ST.	CHIEF, DESIGN SECTION
	ASSO. DISTRICT ENGINEER, TRAFFIC
	CHIEF, TRAFFIC ENGINEERING DIVISION
	DEPUTY CHIEF ENGINEER, OFFICE OF TRAFFIC

MDOT – STATE HIGHWAY ADMINISTRATION
Office of Traffic
TRAFFIC ENGINEERING DIVISION SIGNAL #

ACAD DRAWN BY: DERRICK DICKERSON
DES. BY:
CHK. BY:

MD 528 AND 130TH/131st STREET

COUNTY: WORCESTER

DATE: 2/88
SCALE: 1" = 20'
F.A.P. NO.
S.H.A. NO.
TS/STD. NO. 1433 (G)
SHEET NO. ___ OF ___

23052801.09