F.H.W.A. REGION NO.	STATE	FED. AID PROJ. NO.	SHEET NO.	TOTAL SHEETS
3	MD.		1	2

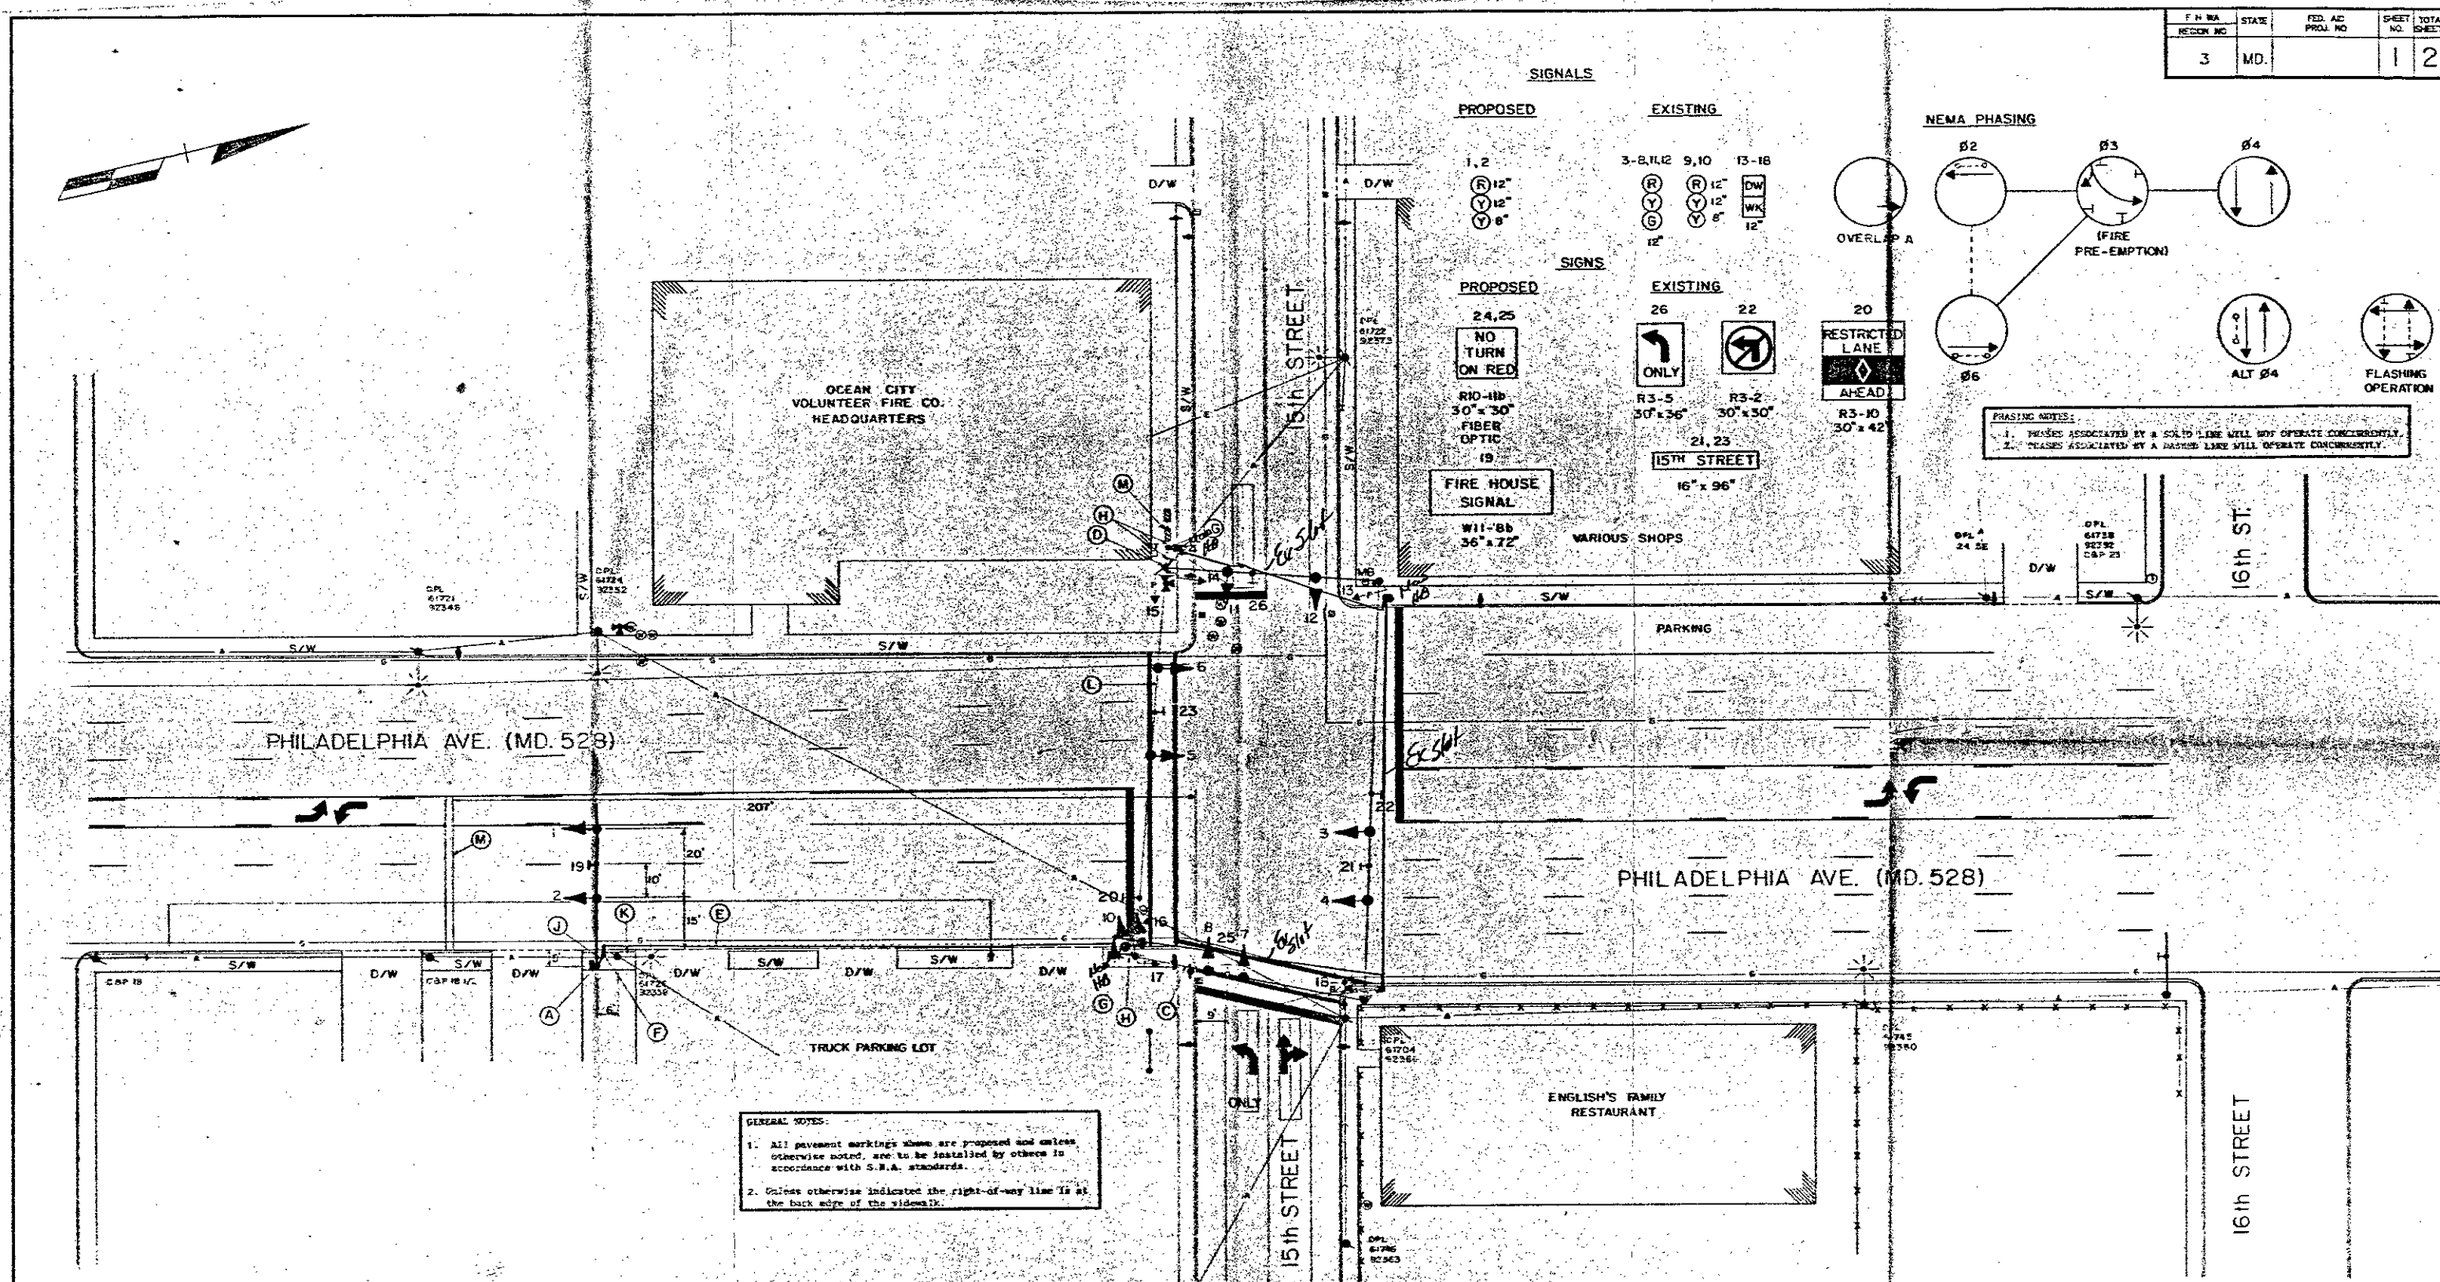

GENERAL NOTES:

1. All pavement markings shown are proposed and unless otherwise noted, are to be installed by others in accordance with S.H.A. standards.
2. Unless otherwise indicated the right-of-way line is at the back edge of the sidewalk.

LEGEND OF UNDERGROUND AND OVERHEAD UTILITIES

AERIAL CABLE — A — A — A — A
ELECTRIC — E — E — E — E
TELEPHONE — T — T — T — T
GAS — G — G — G — G
SEWER — S — S — S — S
WATER — W — W — W — W
CABLE TV — TV — TV — TV — TV

STREET TRAFFIC STUDIES, LTD.
Suite 295, Commerce Park
1777 Reisterstown Road
Baltimore, MD 21208

REVISIONS

⑧ INS. PRE-EMPTION SIGNAL FOR M.B. TRAFFIC 5-15-87
SHA NO. 855-25004375
R.Z. [signature]
A REVISED LOOP DETECTION SHA NO. 855-25001

APPROVALS

CHIEF, SIGNAL DESIGN SECTION
ASST. DISTRICT ENGINEER, TRAFFIC
CHIEF, BUREAU OF TRAFFIC ENGINEERING
DEPUTY CHIEF ENGINEER, OFFICE OF TRAFFIC
ORIGINAL ON FILE

MARYLAND DEPARTMENT OF TRANSPORTATION
STATE HIGHWAY ADMINISTRATION – OFFICE OF TRAFFIC
BUREAU OF TRAFFIC ENGINEERING

23052807.57

DRAWN BY: LISA HANDY
DES. BY:
CHK. BY:

PHILADELPHIA AVE. (MD. 528) & 15th STREET
OCEAN CITY
COUNTY: WORCESTER

DATE: 7-10-85
SCALE: 1" = 20'
F.A.P. NO.
S.H.A. NO. WO-479-001-185
TS/FILE NO. TS-571-B
SHEET NO. 1 OF 2