

**STANDARD TYPE A COMBINATION CURB AND GUTTER
12 INCH GUTTER PAN 8 INCH DEPTH (SHA STD. NO. MD-620.02)**

LOCATION	QUANTITY (LF)
SOUTHWEST QUADRANT	2 102


5 INCH CONCRETE SIDEWALK

LOCATION	QUANTITY (SF)
SOUTHWEST QUADRANT	2 285

**1 DETECTABLE WARNING SURFACE
(SHA STD. NO. MD-655.40)**

LOCATION	QUANTITY (SF)
NORTHWEST QUADRANT	32

TRAVERSE CONTROL POINT 501
N 289,112.0776
E 1,869,850.0621
ELEV. 6.39

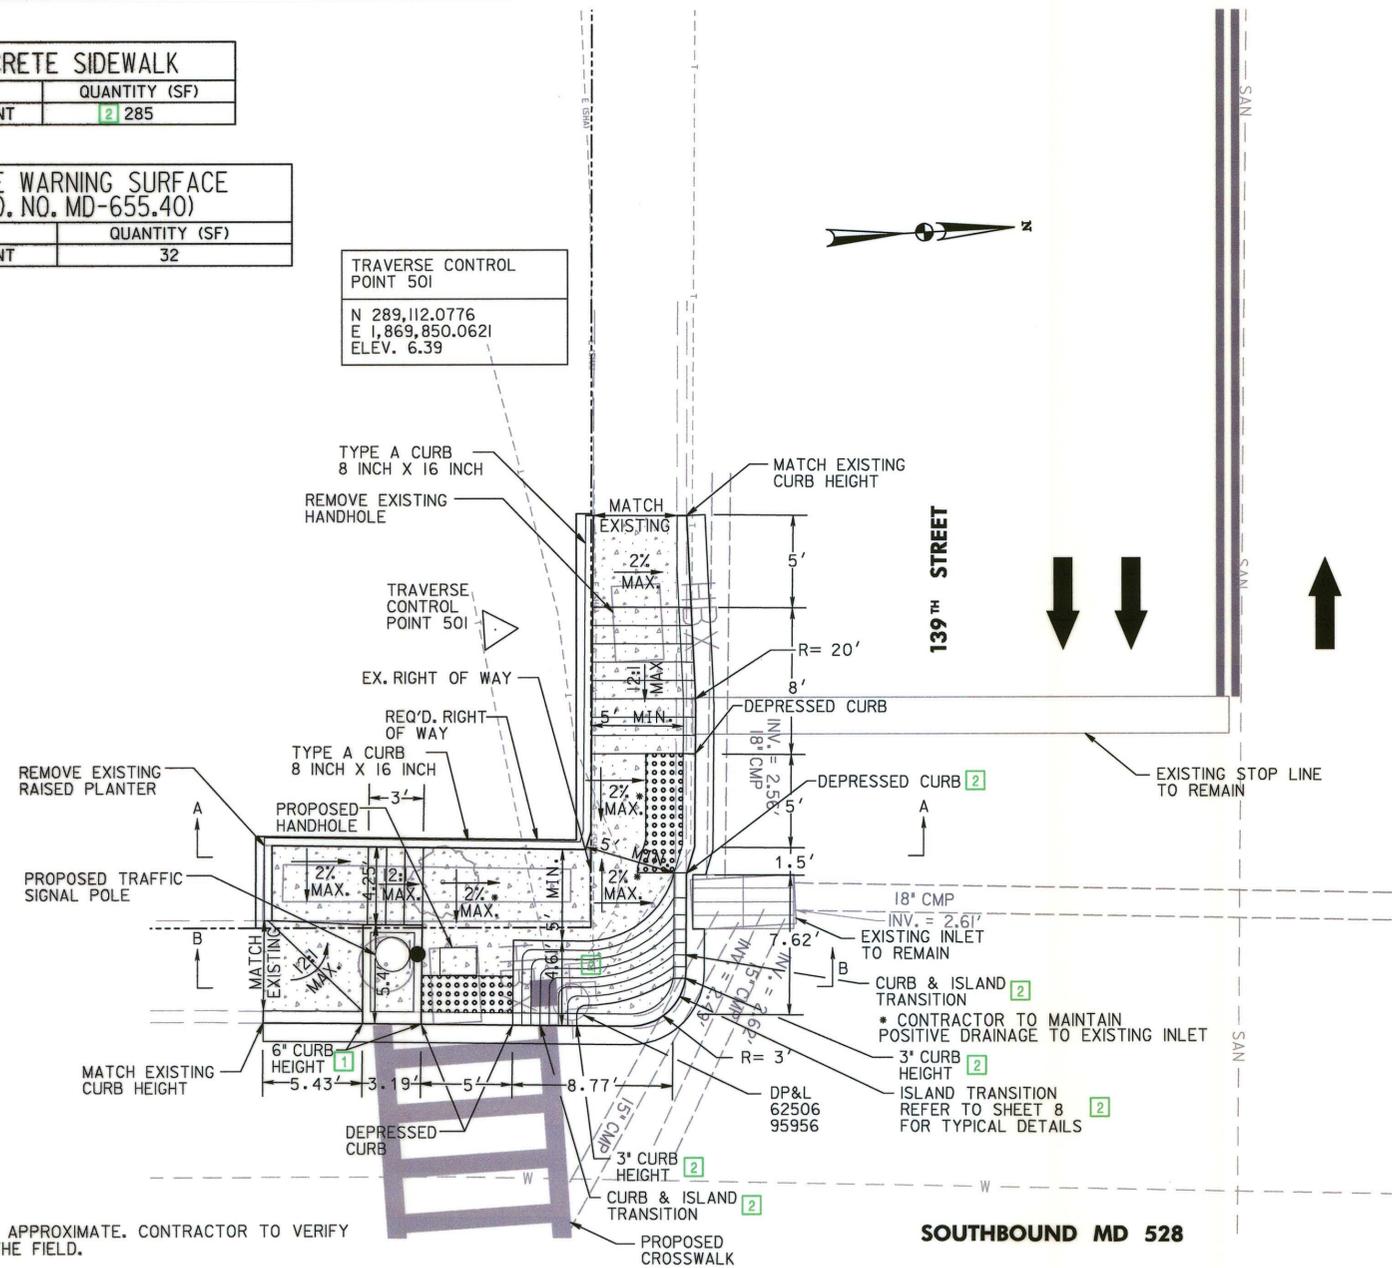

GENERAL NOTES




- ALL DIMENSIONS ARE APPROXIMATE. CONTRACTOR TO VERIFY ALL DIMENSIONS IN THE FIELD.
- NO DISTURBED AREA SHALL BE LEFT UNSTABILIZED OVERNIGHT UNLESS THE RUNOFF IS DIRECTED TO AN APPROVED SEDIMENT CONTROL DEVICE.
- SIDEWALK RECONSTRUCTION LIMITS SHALL COINCIDE WITH CRACK CONTROL JOINTS (JOINTER GROOVES) OR EXPANSION JOINTS IN EXISTING SIDEWALK. NEW EXPANSION JOINTS SHALL BE PROVIDED AT THE INTERFACE OF EXISTING AND PROPOSED SIDEWALK. SEE SHA STD. NO. MD-655.01.
- INSTALL DETECTABLE WARNING SURFACE ON SIDEWALK RAMP AS PER SHA STD. NO. MD-655.40.
- FORM NEW SIDEWALK AND EXPANSION JOINT MATERIAL AROUND EX. UTILITY POLES, MANHOLE COVERS, VALVE COVERS, AND FIRE HYDRANTS AS NECESSARY.
- RESET ANY SIGNS DISTURBED BY THE CONSTRUCTION AS DIRECTED BY THE ENGINEER.
- EXISTING INLETS SHALL NOT BE DAMAGED DURING CONSTRUCTION. DAMAGE TO THE INLETS WILL REQUIRE THE INLET TO BE REPLACED AT NO ADDITIONAL COST TO THE ADMINISTRATION.
- EXISTING TREES, SHRUBS, AND THEIR RESPECTIVE ROOT SYSTEMS SHALL NOT BE DISTURBED DURING CONSTRUCTION.
- CONTRACTOR TO REPLACE SIDEWALK AND CURB IN-KIN FOR ANY SIDEWALK IMPACTED BY PROPOSED CONDUIT BORE.

SOUTHBOUND MD 528

NOTE: SEE SHEET SG-1 FOR ADDITIONAL INFORMATION REGARDING PROPOSED PAVEMENT MARKINGS AND SIGNAL EQUIPMENT

LEGEND

- CONCRETE
- DETECTABLE WARNING SURFACE

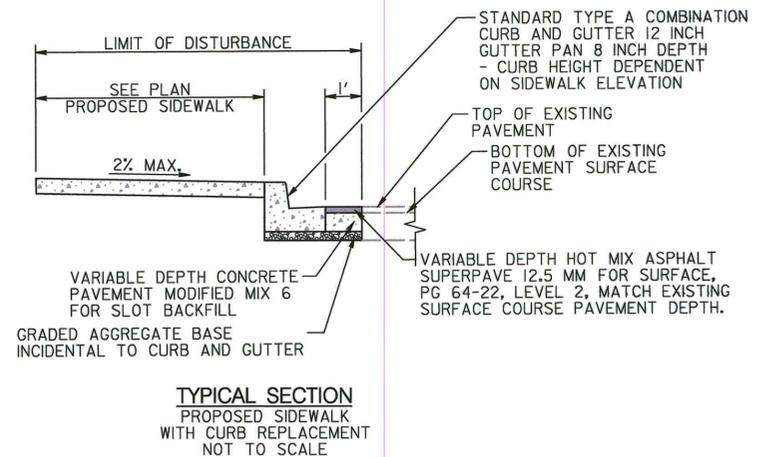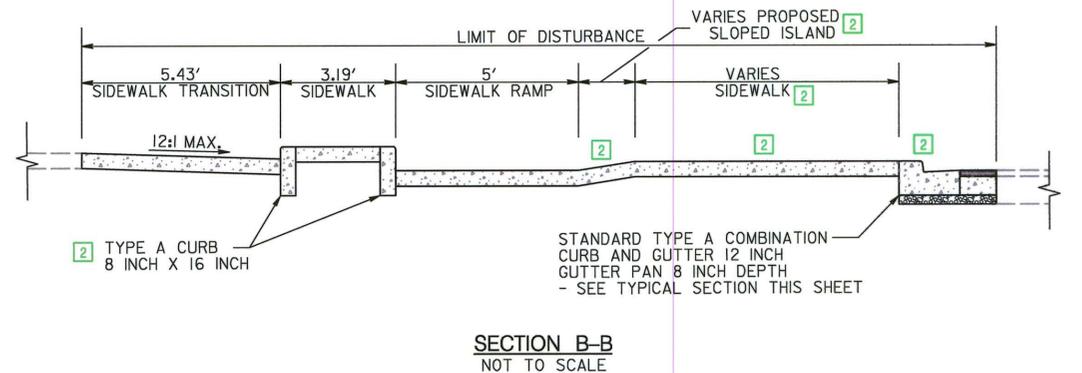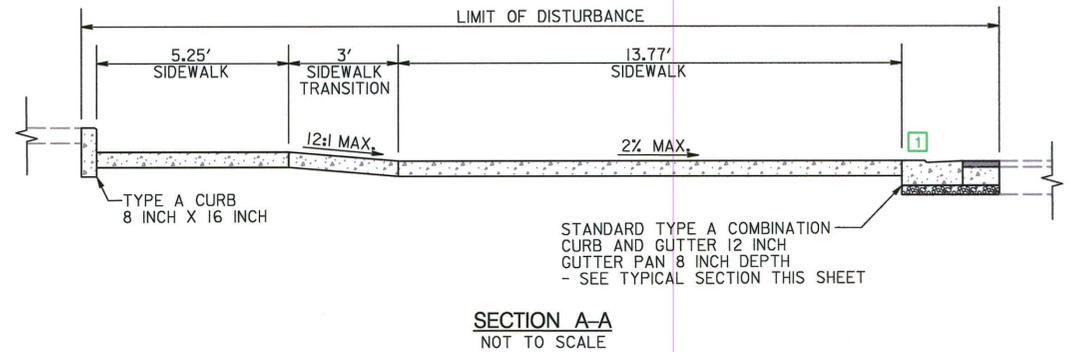

STATE OF MARYLAND
DEPARTMENT OF TRANSPORTATION
STATE HIGHWAY ADMINISTRATION
OFFICE OF TRAFFIC & SAFETY
TRAFFIC ENGINEERING DESIGN DIVISION

**MD 528 (COASTAL HIGHWAY) AT 139 ST.
OCEAN CITY, MD.**

RAMP DETAILS

SCALE	1" = 5'	DATE	MAY 2010	CONTRACT NO.	XX4435185
DESIGNED BY	WRW	COUNTY	WORCESTER		
DRAWN BY	JBB	LOGMILE			
CHECKED BY	ATD	TMS NO.	K186		
FAP NO.		TOD NO.			
TS NO.	2316C-DE	DRAWING	DE-01	OF	1
				SHEET NO.	3 OF 3

RK&K
RUMMEL, KLEPPER & KAHL, LLP
81 MOSHER STREET | BALTIMORE, MD 21217
PH: (410) 728-2900 FAX: (410) 728-3180

Engineers | Construction Managers | Planners | Scientists
www.rkk.com

REVISIONS

1	GREENLINE NO. 1 12/01/2010 REVISE DWSCURB
2	GREENLINE NO. 2 01/12/2010 REVISE DWSCURB