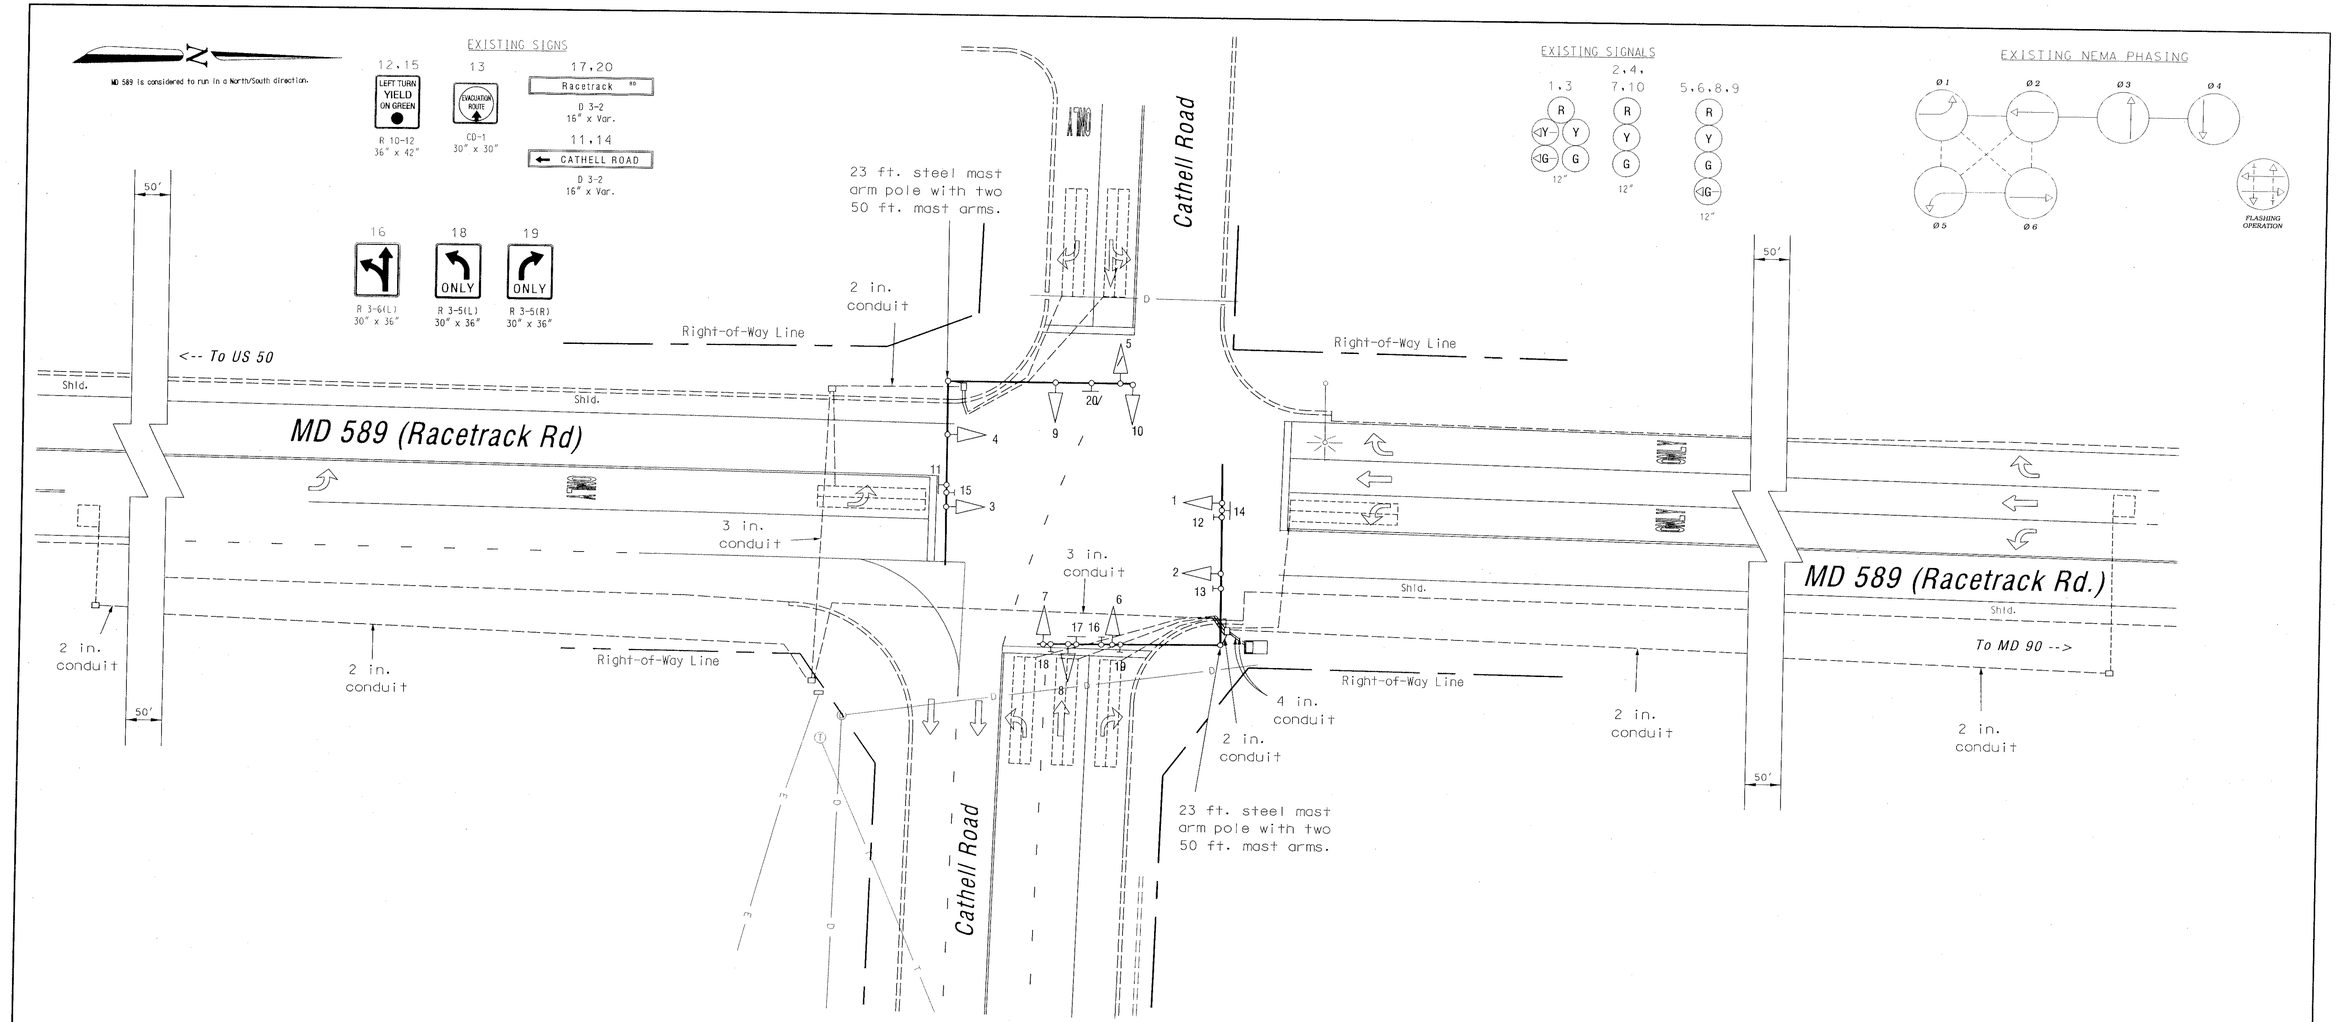

GEOMETRIC LEGEND

EXISTING GEOMETRICS

PROPOSED GEOMETRICS

UTILITY LEGEND

G	GAS MAIN
W	WATER MAIN
S	SEWER MAIN
E	ELECTRIC CABLES
D	STORM DRAIN
A	AERIAL CABLES
T	TELEPHONE CABLES

"AS-BUILT"

The Traffic Group

The Traffic Group, Inc.
410-583-8405
Fax 410-321-8458

REVISIONS

January 2, 2001
AS-BUILT
S.H.A. No.: BW996M82
fjh

APPROVALS

ORIGINAL ON FILE

TEAM LEADER, TRAFFIC ENGINEERING DESIGN DIVISION

ASST. CHIEF TRAFFIC ENGINEERING DESIGN DIVISION

CHIEF, TRAFFIC ENGINEERING DESIGN DIVISION

DIRECTOR, TRAFFIC & SAFETY

MARYLAND DOT - STATE HIGHWAY ADMINISTRATION
Office of Traffic & Safety
TRAFFIC ENGINEERING DESIGN DIVISION
(Traffic Signal Plan)

MD 589 at Cathell Rd.

DRAWN BY: John Dirndorfer	F.A.P. NO. N/A	TS NO. 2290A	SHEET NO.
CHECKED BY:	S.H.A. NO. 855-25004		
SCALE: 1" = 20'	COUNTY: Worchester	T.I.M.S. NO. D-557	1 OF 1
DATE: February 27, 1987	LOG MILE: XXX		

I:\1989\980229\dwg\cathellsignal.dgn 09 JAN 2001