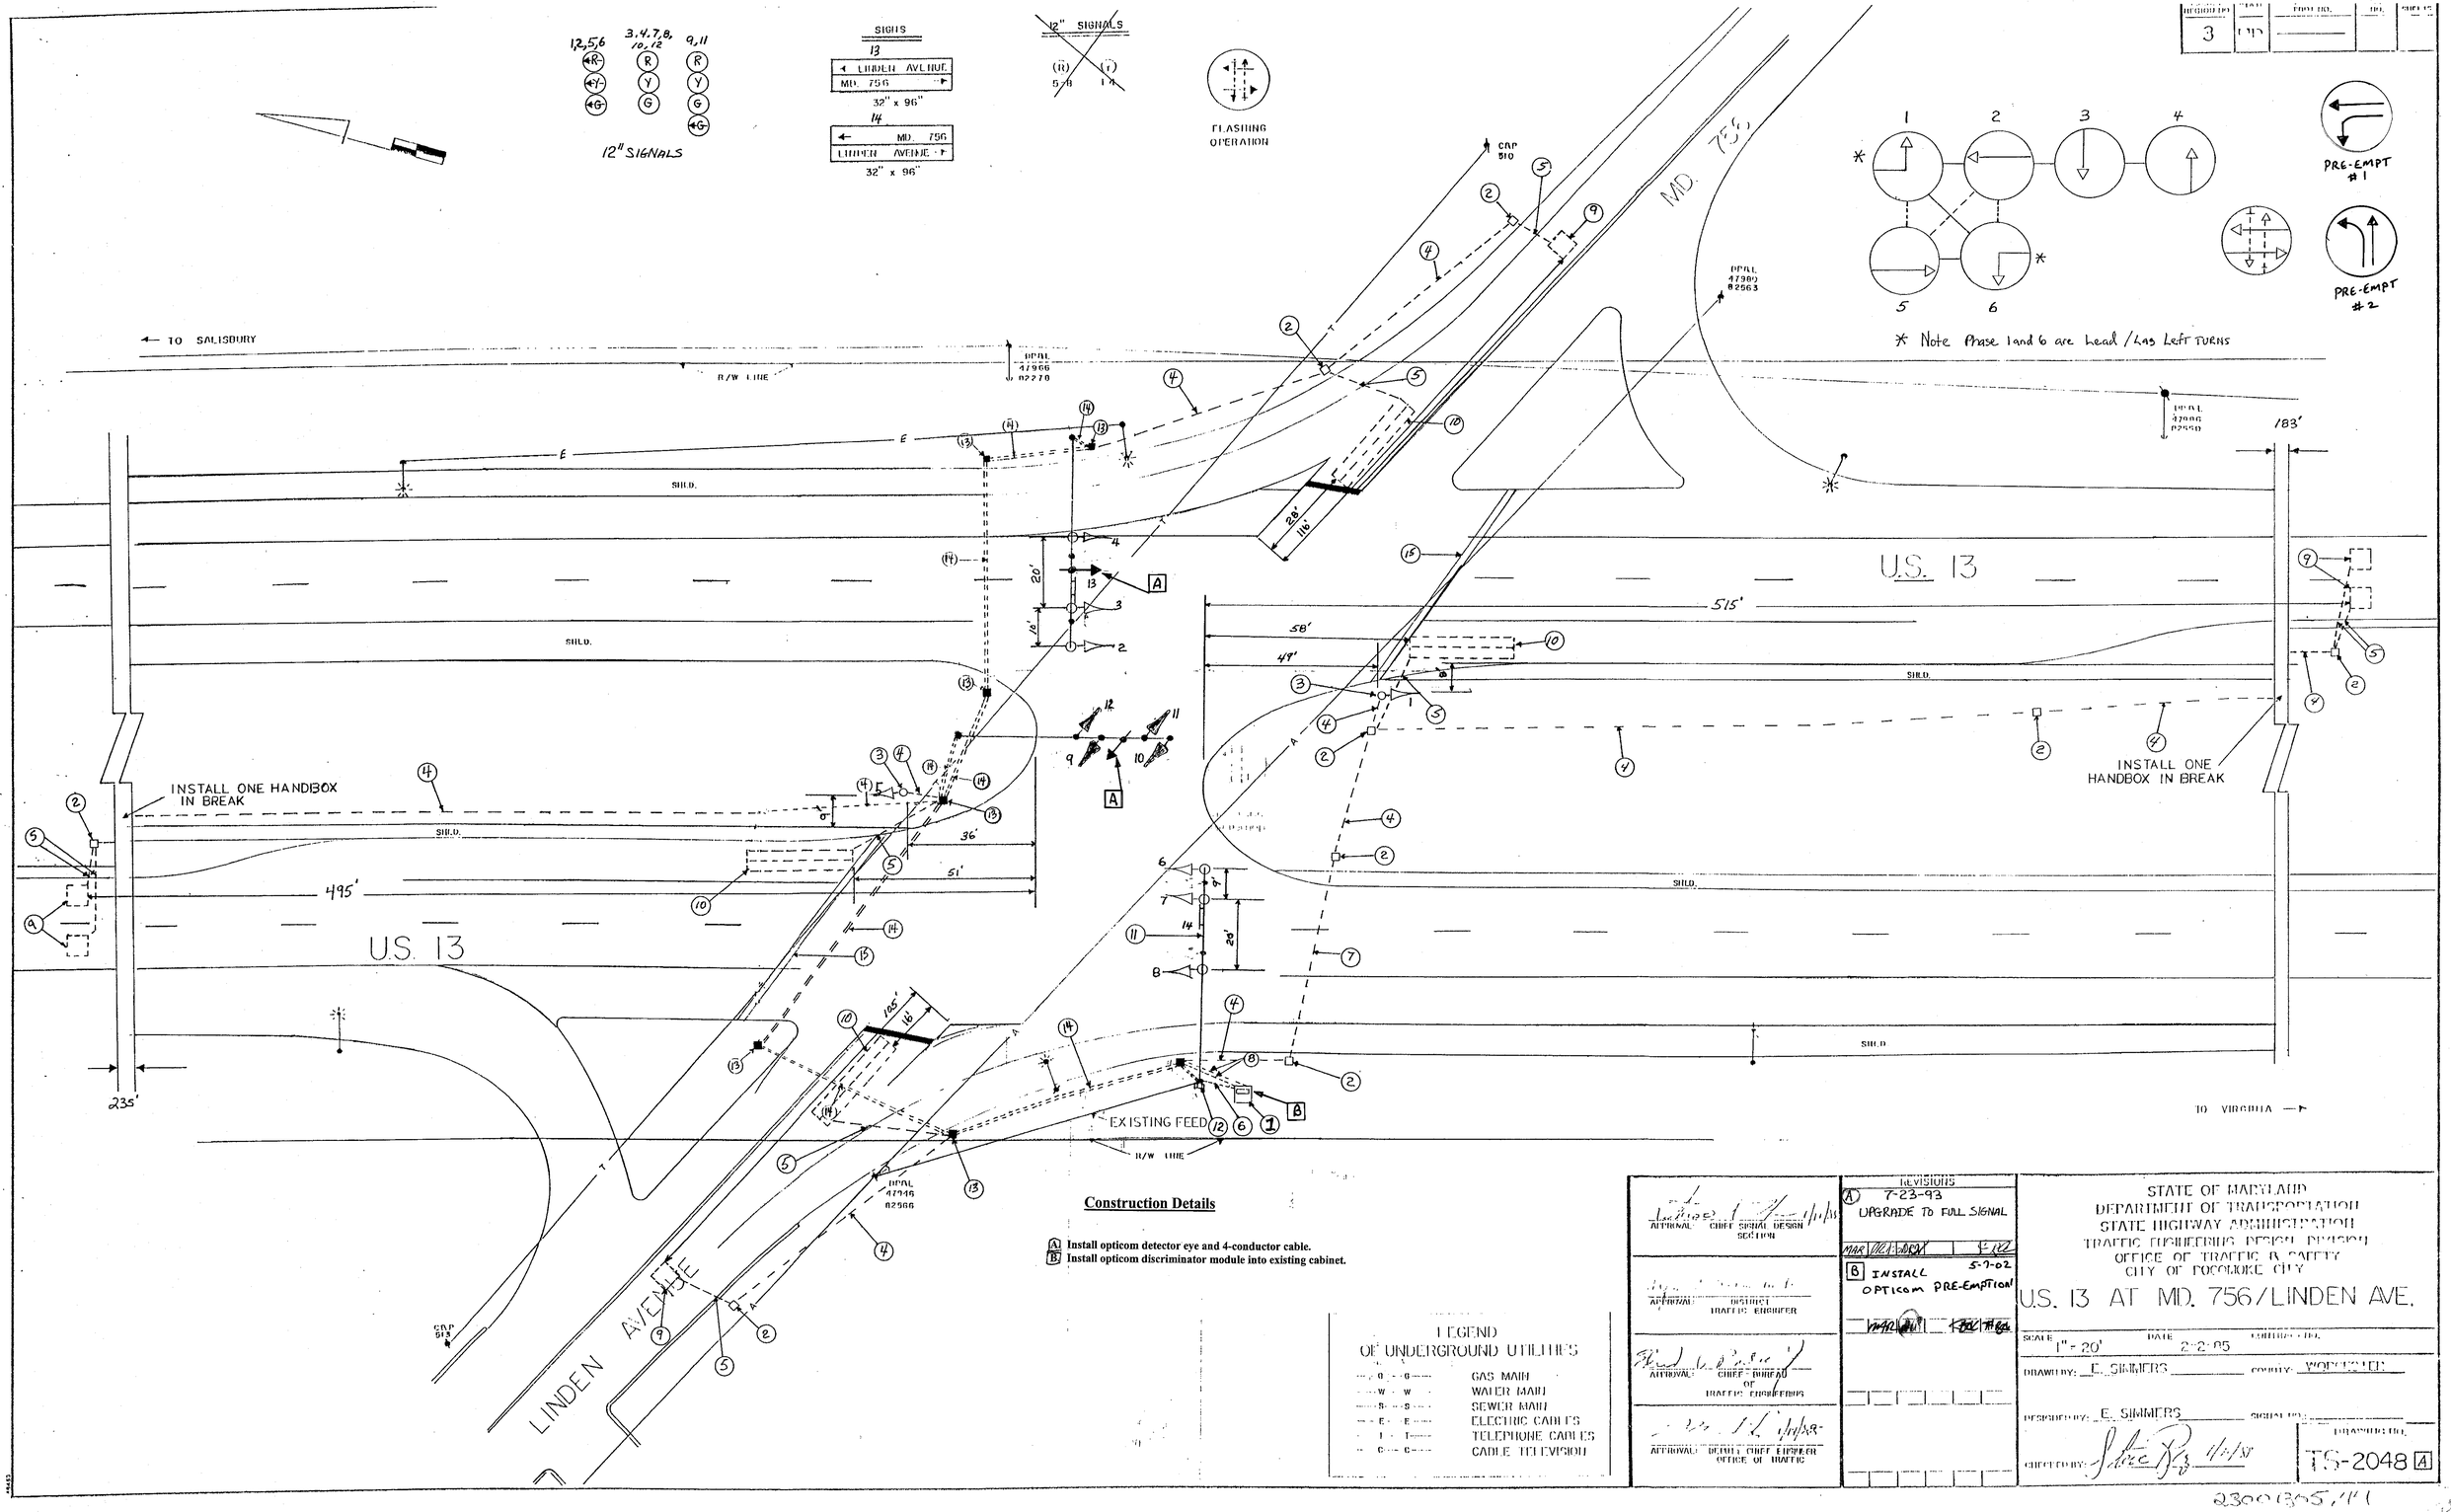

Construction Details

A Install opticom detector eye and 4-conductor cable.
B Install opticom discriminator module into existing cabinet.

LEGEND OF UNDERGROUND UTILITIES

G	GAS MAIN
W	WATER MAIN
S	SEWER MAIN
E	ELECTRIC CABLES
T	TELEPHONE CABLES
C	CABLE TELEVISION

APPROVAL: CHIEF SIGNAL DESIGN SECTION

APPROVAL: DISTRICT TRAFFIC ENGINEER

APPROVAL: CHIEF BUREAU OF TRAFFIC ENGINEERING

APPROVAL: DEPUTY CHIEF ENGINEER OFFICE OF TRAFFIC

REVISIONS

A 7-23-93 UPGRADE TO FULL SIGNAL

B INSTALL OPTICOM PRE-EMPTION 5-7-02

STATE OF MARYLAND
DEPARTMENT OF TRANSPORTATION
STATE HIGHWAY ADMINISTRATION
TRAFFIC ENGINEERING DESIGN DIVISION
OFFICE OF TRAFFIC & SAFETY
CITY OF POCOMOKE CITY

U.S. 13 AT MD. 756/LINDEN AVE.

SCALE 1" = 20' DATE 2-2-85 CONTRACT NO.

DRAWN BY: E. SIMMERS COUNTY: WORCESTER

DESIGNED BY: E. SIMMERS SIGNAL NO.:

CHECKED BY: DRAWING NO. TS-2048 A

23001305.141