F H WA REGION NO	STATE	FED. AID PROJ. NO	SHEET NO.	TOTAL SHEETS
3	MD.	SEE TITLE SHEET	49	53

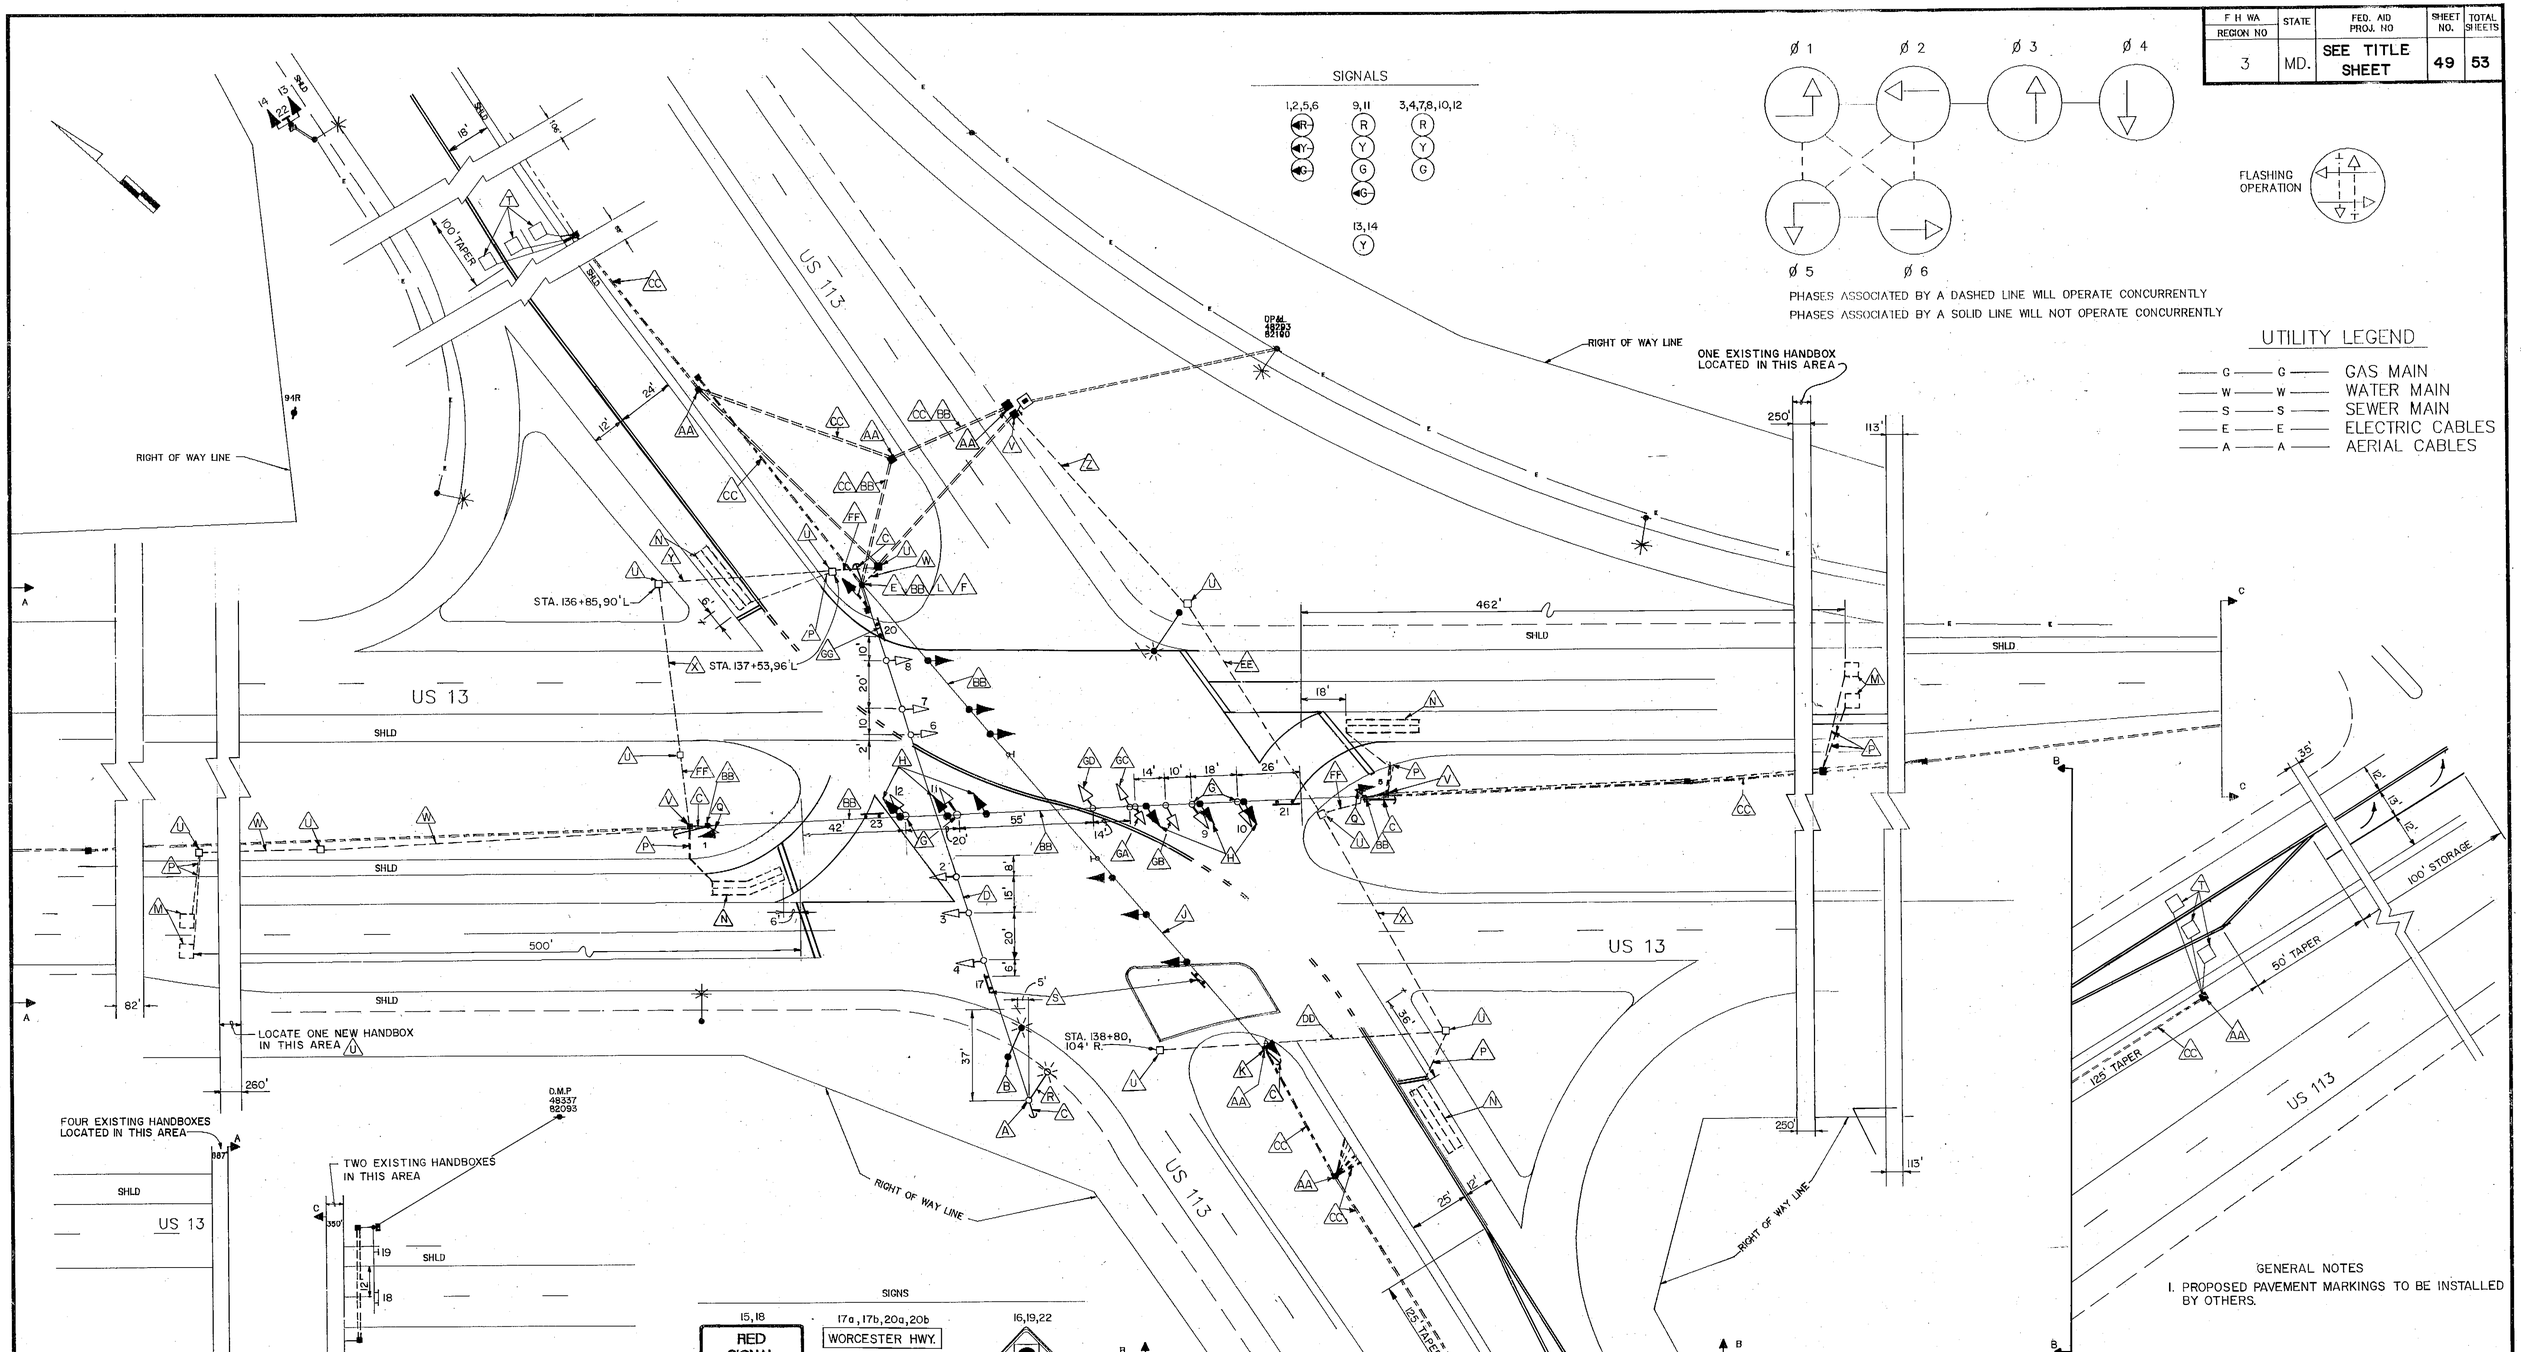

WHITMAN, REQUARDT AND ASSOCIATES ENGINEERS
BALTIMORE, MARYLAND
(REVISIONS F & G)

REVISIONS

G 11/92 RELOCATE TEMP. SIGNAL HEADS S.H.A. NO.: WO-679-501-176

F 11/92 INSTALL TEMP STRAIN POLE, SPAN WIRE, SIGNALS, CONDUIT & DETECTORS. S.H.A. NO.: WO-679-501-176

E 11/91 INSTALL FIBEROPTIC SIGN AND CONDUIT FOR NB US 13 S.H.A. NO.: 855-2504Q016

APPROVALS

CHIEF, SIGNAL DESIGN SECTION

ASST. DISTRICT ENGINEER, TRAFFIC

CHIEF, TRAFFIC ENGINEERING DIVISION

DEPUTY CHIEF ENGINEER, OFFICE OF TRAFFIC

THIS IS A REVISION TO S.H.A. CONTRACT NO. WO 487X-000-185 ON FILE IN THE OFFICE OF TRAFFIC

MARYLAND DEPARTMENT OF TRANSPORTATION
STATE HIGHWAY ADMINISTRATION – OFFICE OF TRAFFIC
TRAFFIC ENGINEERING DIVISION

DRAWN BY: BRUCE THOMPSON
DES. BY: BRUCE THOMPSON
CHK. BY: A.BUDNICHUK 1/11/75

US 13 and US 113

ACAD 23001304.55

COUNTY: WORCESTER

DATE: REDRAWN 8/90
SCALE: 1"=30'

F.A.P. NO.
S.H.A. NO. WO 487X-000-185

TS/FILE NO. 392 F & G

SHEET NO. 49 OF 53