K&E 19 1153 6-81 MC 2647

F.H.W.A. REGION NO.	STATE	FED. AID PROJ. NO.	SHEET NO.	TOTAL SHEETS
3	MD.		2	5

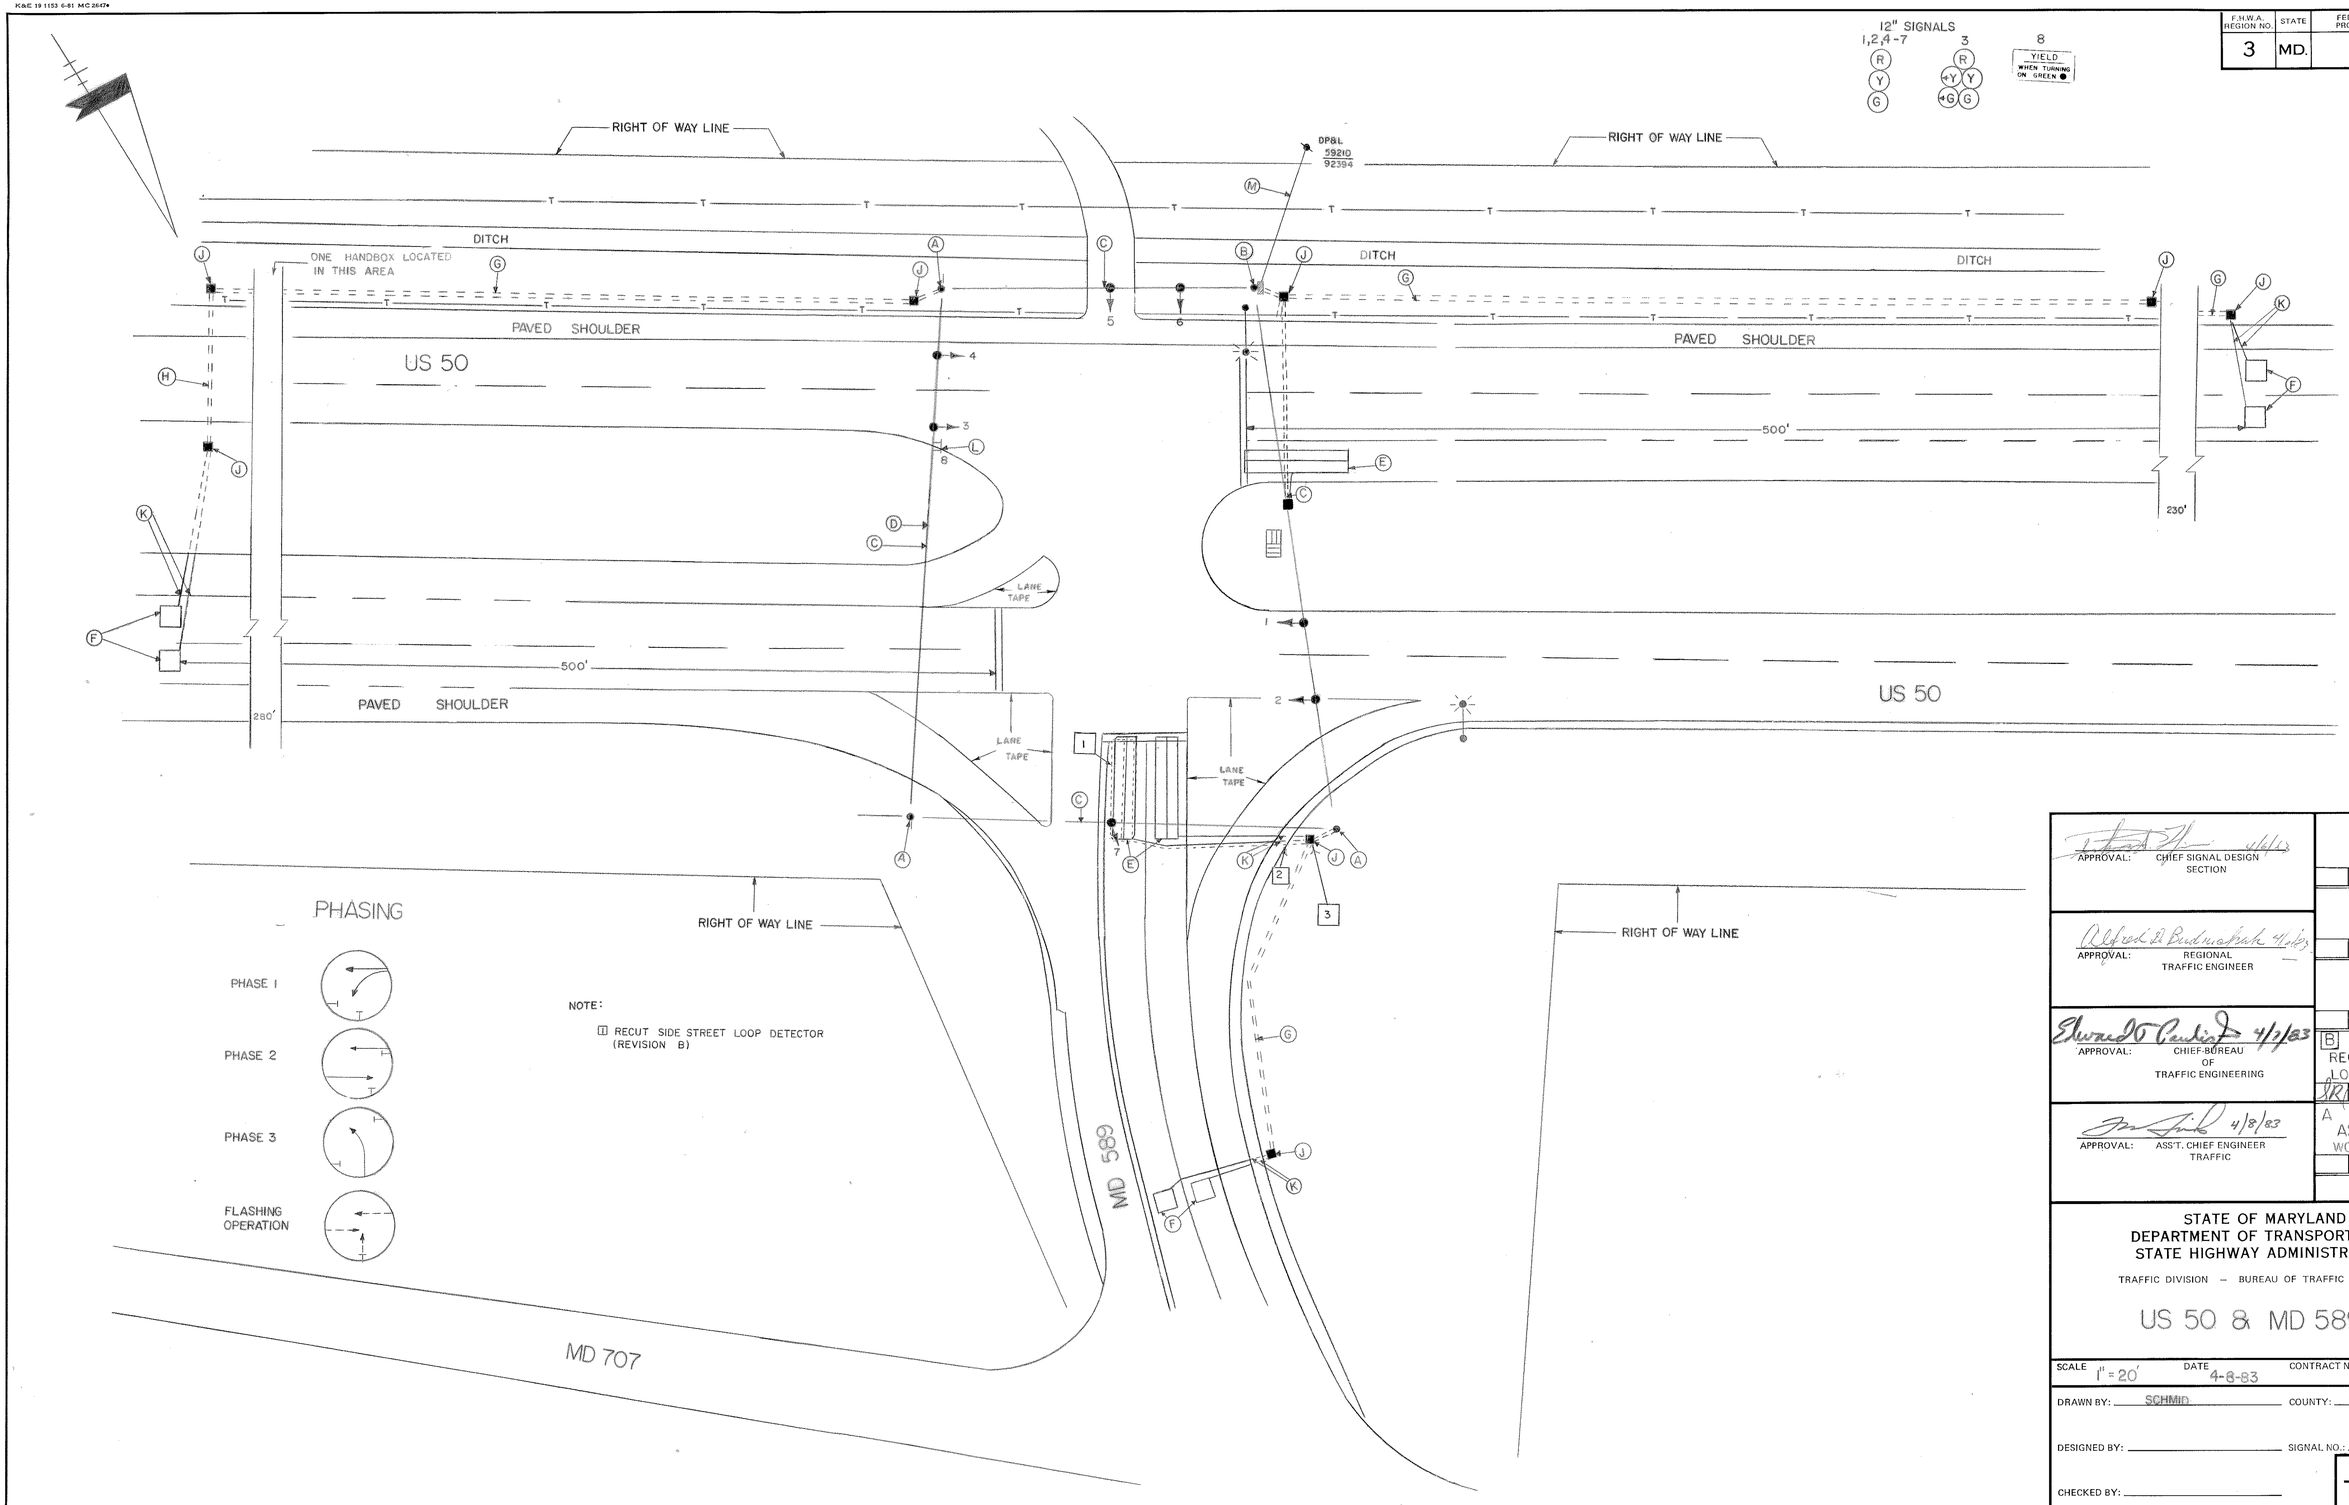

APPROVAL: CHIEF SIGNAL DESIGN SECTION 4/6/83

APPROVAL: REGIONAL TRAFFIC ENGINEER 4/6/83

APPROVAL: CHIEF-BUREAU OF TRAFFIC ENGINEERING 4/7/83

APPROVAL: ASS'T. CHIEF ENGINEER TRAFFIC 4/8/83

B 7-24-86 RECUT SIDE STREET LOOP DETECTOR

A 7-24-86 ASBUILT WO 603-501-185

REVISIONS

STATE OF MARYLAND
DEPARTMENT OF TRANSPORTATION
STATE HIGHWAY ADMINISTRATION

TRAFFIC DIVISION – BUREAU OF TRAFFIC ENGINEERING

US 50 & MD 589

SCALE 1" = 20' DATE 4-8-83 CONTRACT NO. WO-603-501-185

DRAWN BY: SCHMID COUNTY: WORCHESTER

DESIGNED BY: SIGNAL NO.: 23005009.64

CHECKED BY:

DRAWING NO. TS-375B