REVISION "A"

CONSTRUCTION DETAIL

A. INSTALL W3-3(4) SIGN ONTO EXISTING MAST ARM AS SHOWN.

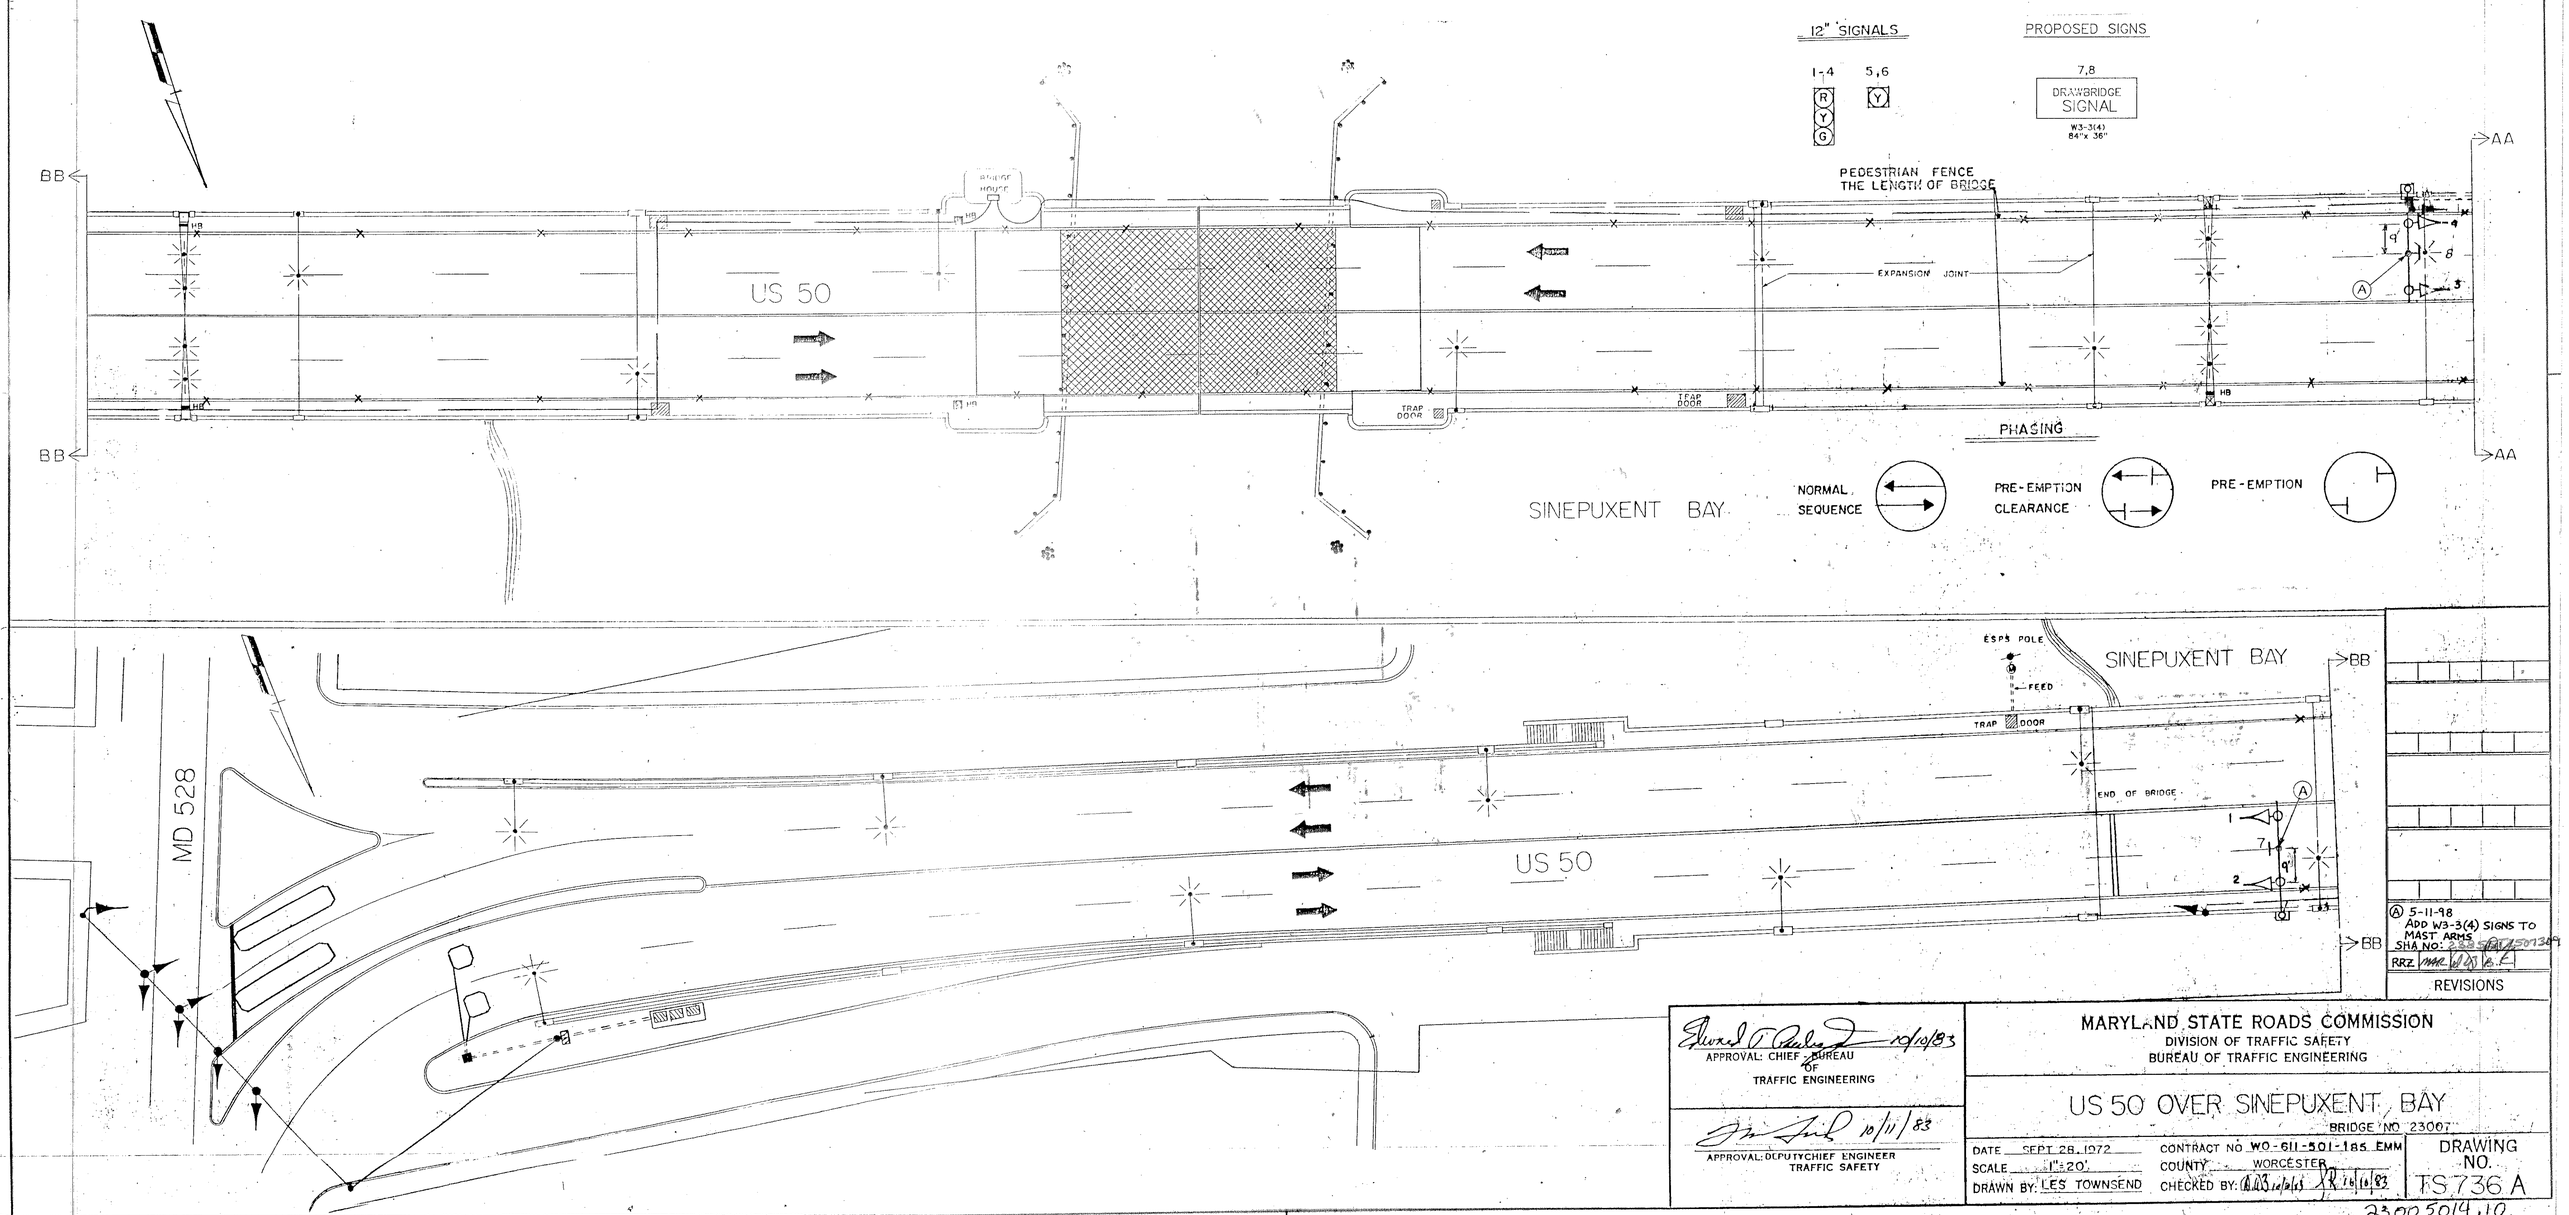

Ⓐ 5-11-98
ADD W3-3(4) SIGNS TO MAST ARMS
SHA NO: 2385 [illegible] 507309
RRZ MAR [illegible]

REVISIONS

APPROVAL: CHIEF - BUREAU OF TRAFFIC ENGINEERING 10/10/83

APPROVAL: DEPUTY CHIEF ENGINEER TRAFFIC SAFETY 10/11/83

MARYLAND STATE ROADS COMMISSION
DIVISION OF TRAFFIC SAFETY
BUREAU OF TRAFFIC ENGINEERING

US 50 OVER SINEPUXENT BAY
BRIDGE NO 23007

DATE SEPT 28, 1972
SCALE 1"=20'
DRAWN BY: LES TOWNSEND
CONTRACT NO WO-611-501-185 EMM
COUNTY WORCESTER
CHECKED BY: [illegible] 10/10/83

DRAWING NO. TS 736 A

23005014.10