F H WA REGION NO	STATE	FED. AID PROJ. NO	SHEET NO.	TOTAL SHEETS
3	MD.			

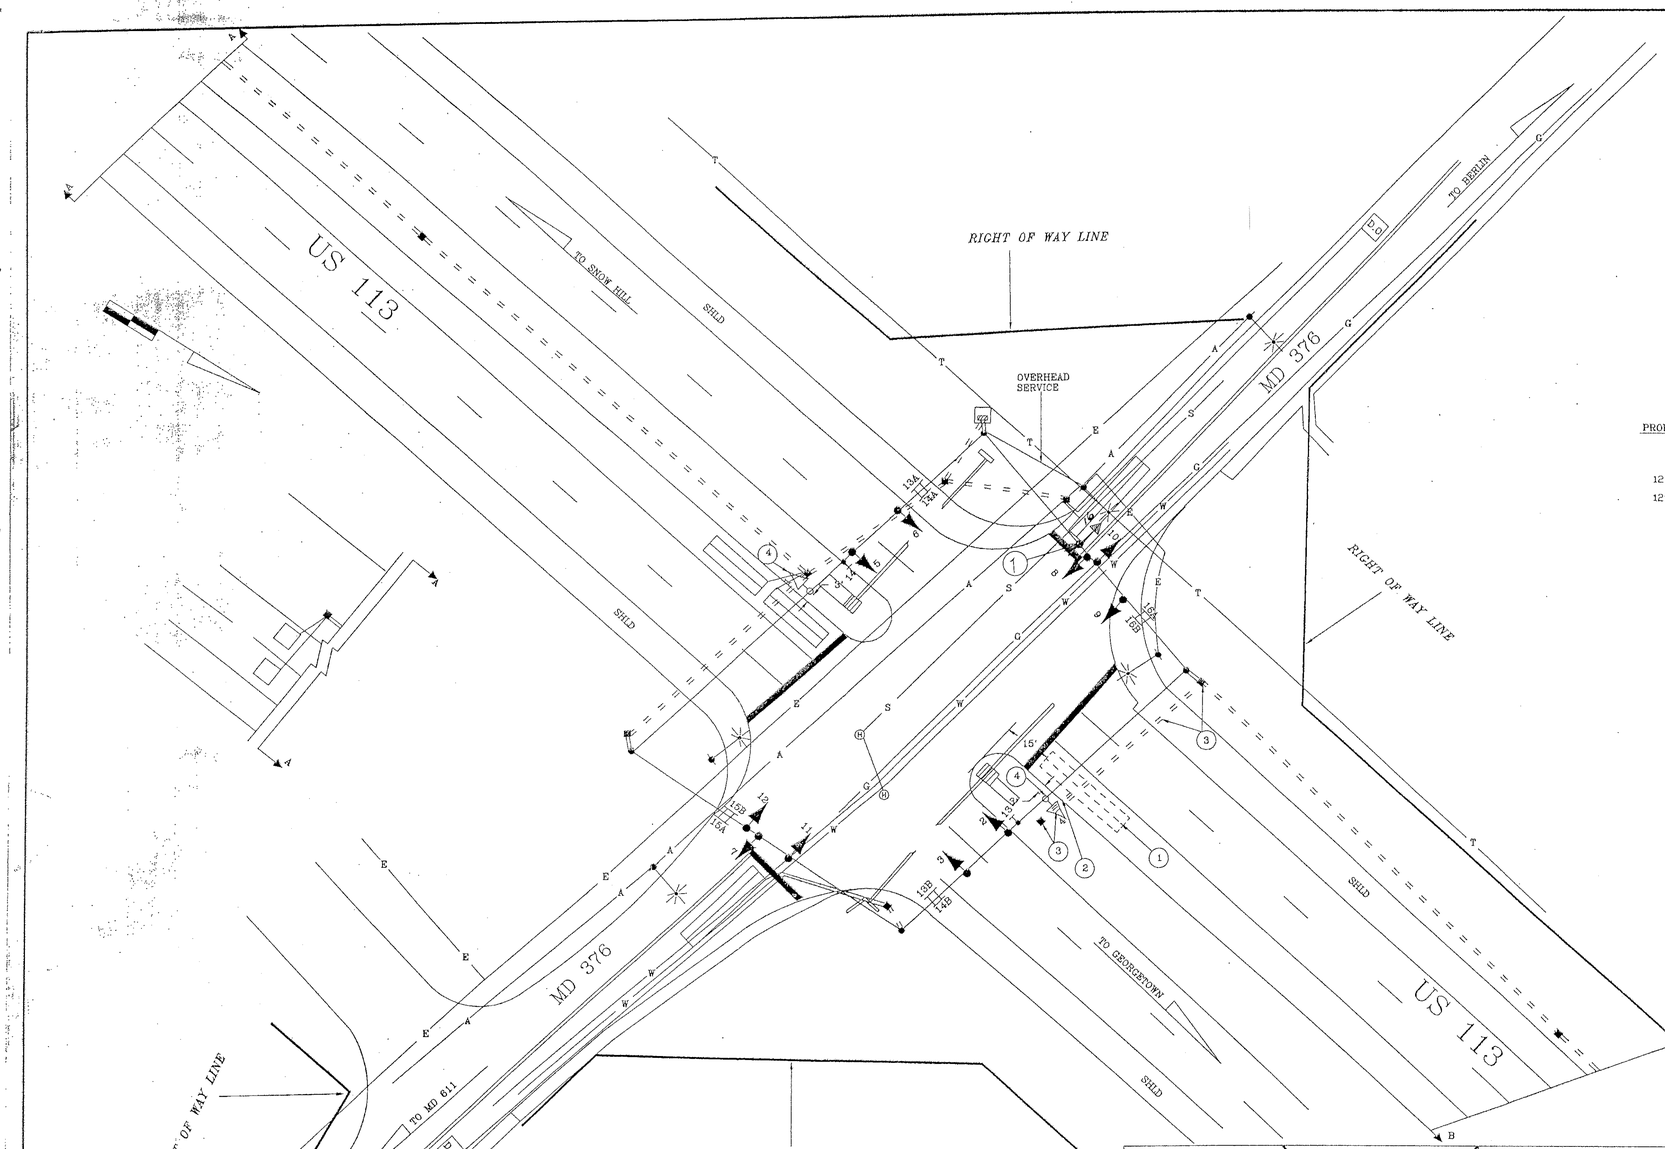

NEMA PHASING

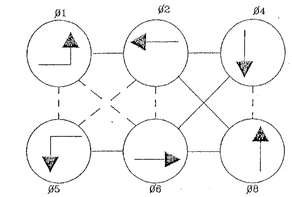

PHASES ASSOCIATED BY A DASHED LINE WILL OPERATE CONCURRENTLY
PHASES ASSOCIATED BY A SOLID LINE WILL NOT OPERATE CONCURRENTLY

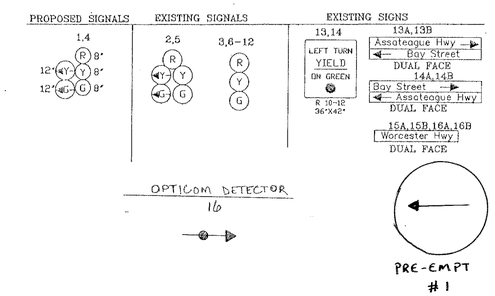

CONSTRUCTION DETAILS

1. INSTALL OPTICOM DETECTOR EYE.

UTILITY LEGEND

- G — G — GAS MAIN
- W — W — WATER MAIN
- S — S — SEWER MAIN
- E — E — ELECTRIC CABLES
- A — A — AERIAL CABLES
- T — T — TELEPHONE CABLES

REVISIONS	APPROVALS
B 9/00 INSTALL OPTICOM DETECTOR FOR E/B MD 376	ORIGINAL — CHIEF, SIGNAL DESIGN SECTION — ON — ASST. DISTRICT ENGINEER, TRAFFIC
A 9/92 INSTALL SOUTHBOUND LEFT TURN LOOP DETECTOR	CHIEF, TRAFFIC ENGINEERING DESIGN DIVISION — FILE — DIRECTOR, OFFICE OF TRAFFIC & SAFETY

MDOT – STATE HIGHWAY ADMINISTRATION
Office of Traffic & Safety
TRAFFIC ENGINEERING DESIGN DIVISION — SIGNAL # 23011328.08

DRAWN BY: LEE SHORT
DES. BY: BRUCE THOMPSON
CHK. BY:

US 113 AND MD 376

T.I.M.S. NO. E 025 — COUNTY: WORCESTER

DATE: 9/27/79 — F.A.P. NO.
SCALE: 1" = 20' — S.H.A. NO. 23854T2302820

TS/STD. NO. TS-1739 (B) — SHEET NO. 2 OF 3

F# 61

23011328.08