F H WA REGION NO	STATE	FED. AID PROJ. NO	SHEET NO.	TOTAL SHEETS
3	MD.			

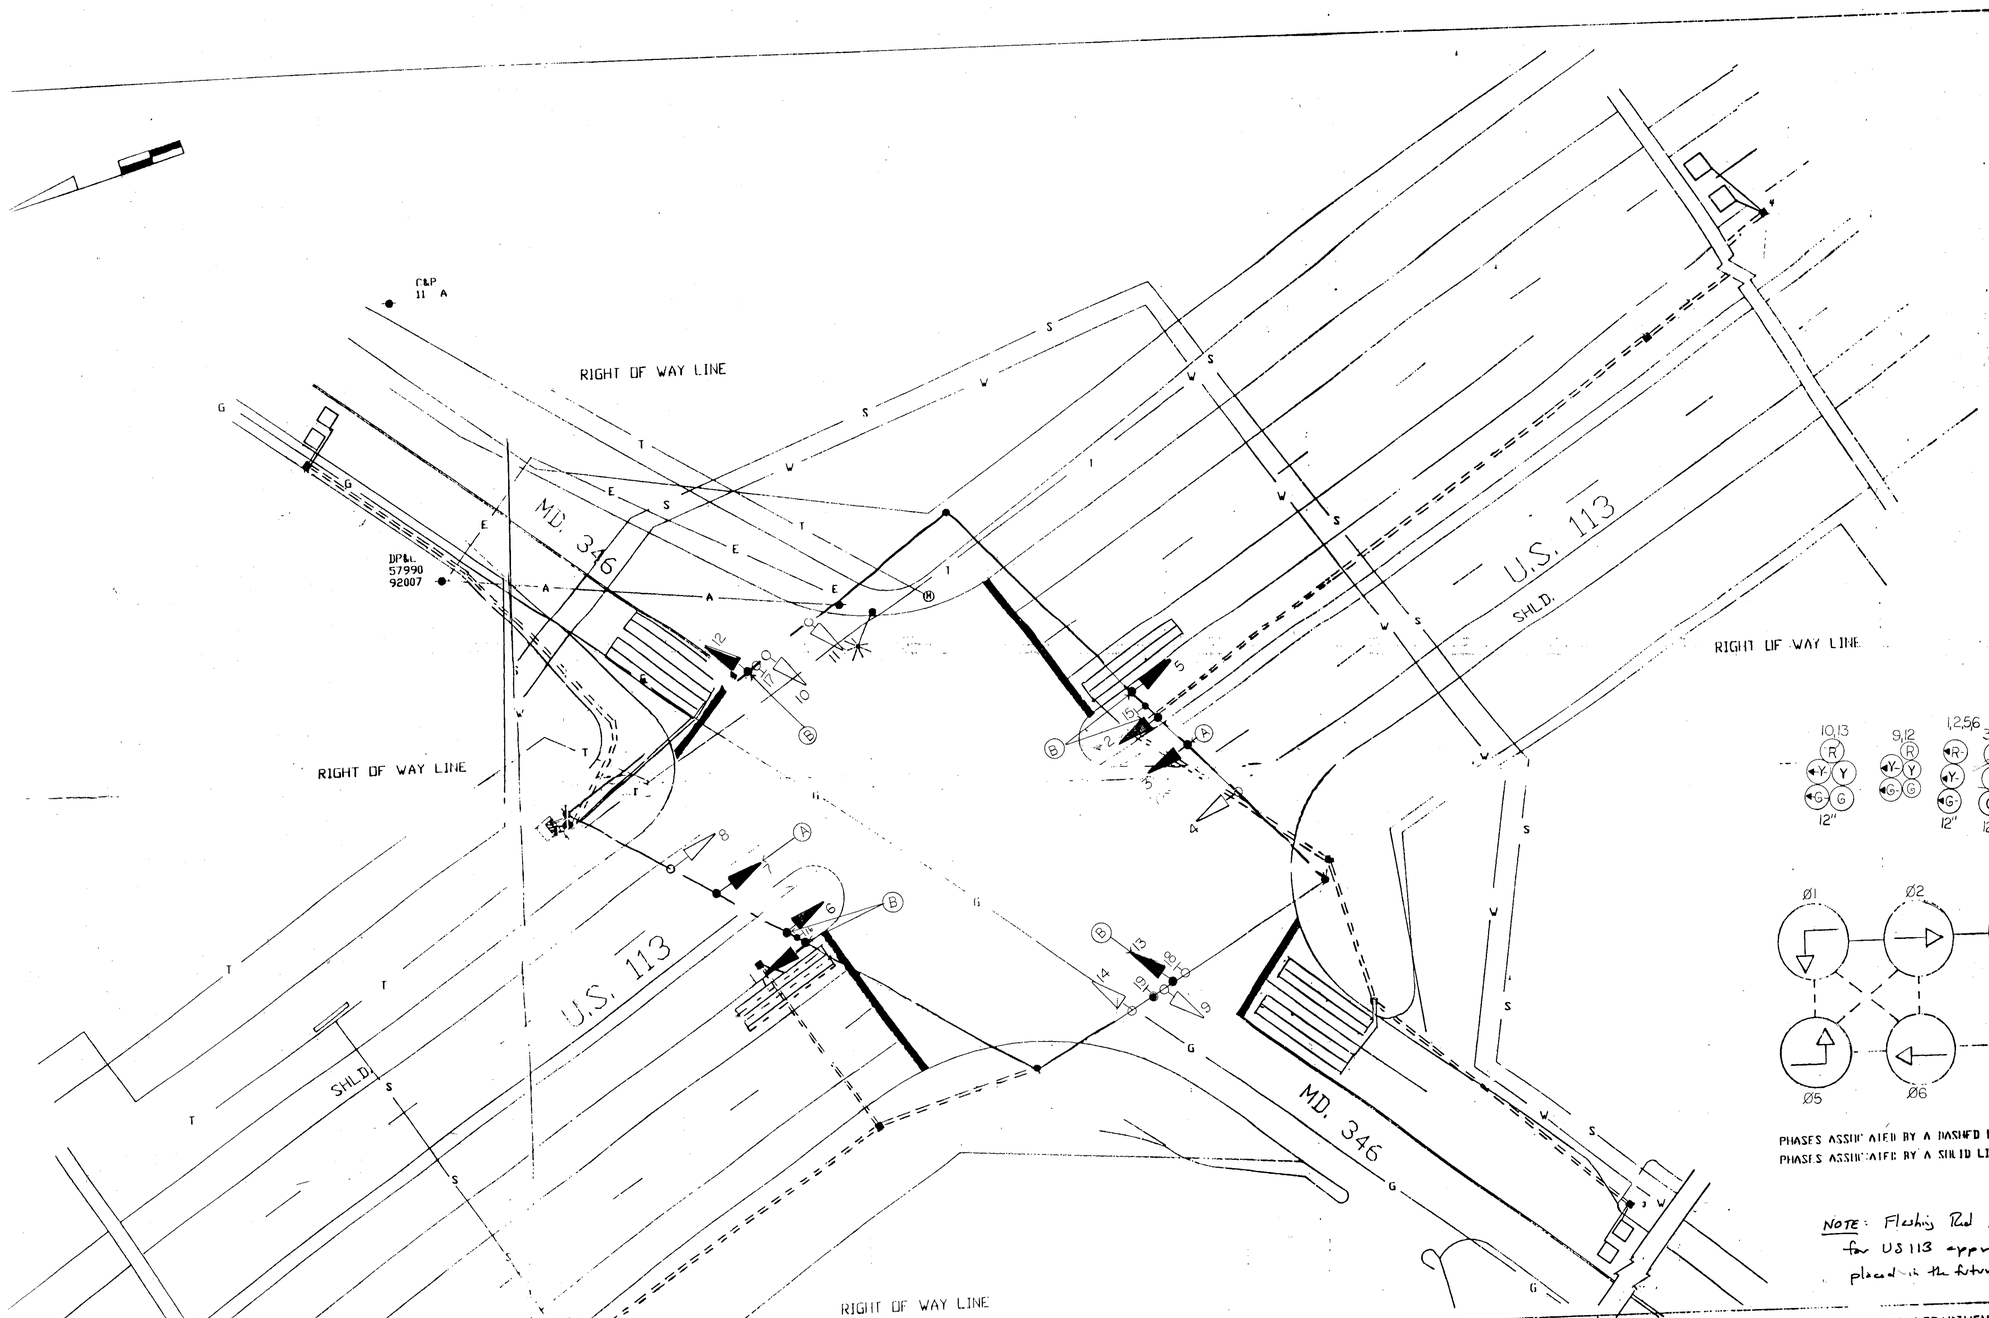

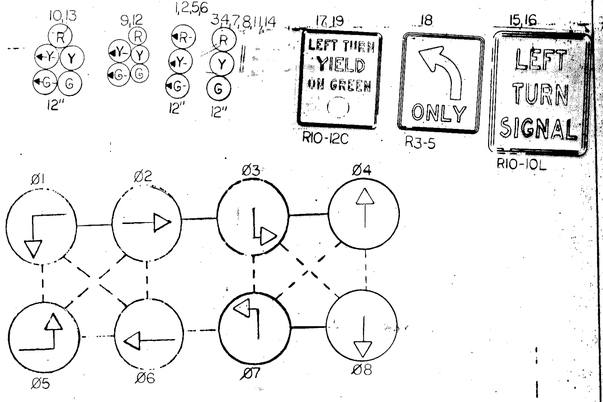

PHASES ASSOCIATED BY A DASHED LINE WILL OPERATE CONCURRENTLY
PHASES ASSOCIATED BY A SOLID LINE WILL NOT OPERATE CONCURRENTLY

NOTE: Flashing Red Left Turn Arrows for US 113 approaches will be placed in the future. T.Hicks 10/29/97

CONSTRUCTION DETAILS

A. REMOVE EXISTING SIGNAL HEAD AND INSTALL THREE SECTION
B. INSTALL SIGNAL HEAD

REVISIONS	APPROVALS
B EXCLUSIVE LT NB & SB US 113 E/D LT WB MD 346 10/97	CHIEF, SIGNAL DESIGN SECTION
A	ASSI. DISTRICT ENGINEER, TRAFFIC
	CHIEF, TRAFFIC ENGINEERING DIVISION
	DEPUTY CHIEF ENGINEER, OFFICE OF TRAFFIC

MARYLAND DEPARTMENT OF TRANSPORTATION
STATE HIGHWAY ADMINISTRATION – OFFICE OF TRAFFIC
TRAFFIC ENGINEERING DIVISION

SIGNAL #23011328.88

DRAWN BY
DES. BY: BLT
CHK. BY:
DATE: 9-24-79
SCALE: 1" = 20'

US 113 @ MD 346

COUNTY: Worcester

F.A.P. NO.
S.H.A. NO.
TS/FILE NO. 1738(B)
SHEET NO. ___ OF ___