F.H.W.A. REGION NO.	STATE	FED. AID PROJ. NO.	SHEET NO.	TOTAL SHEETS
3	MD.			

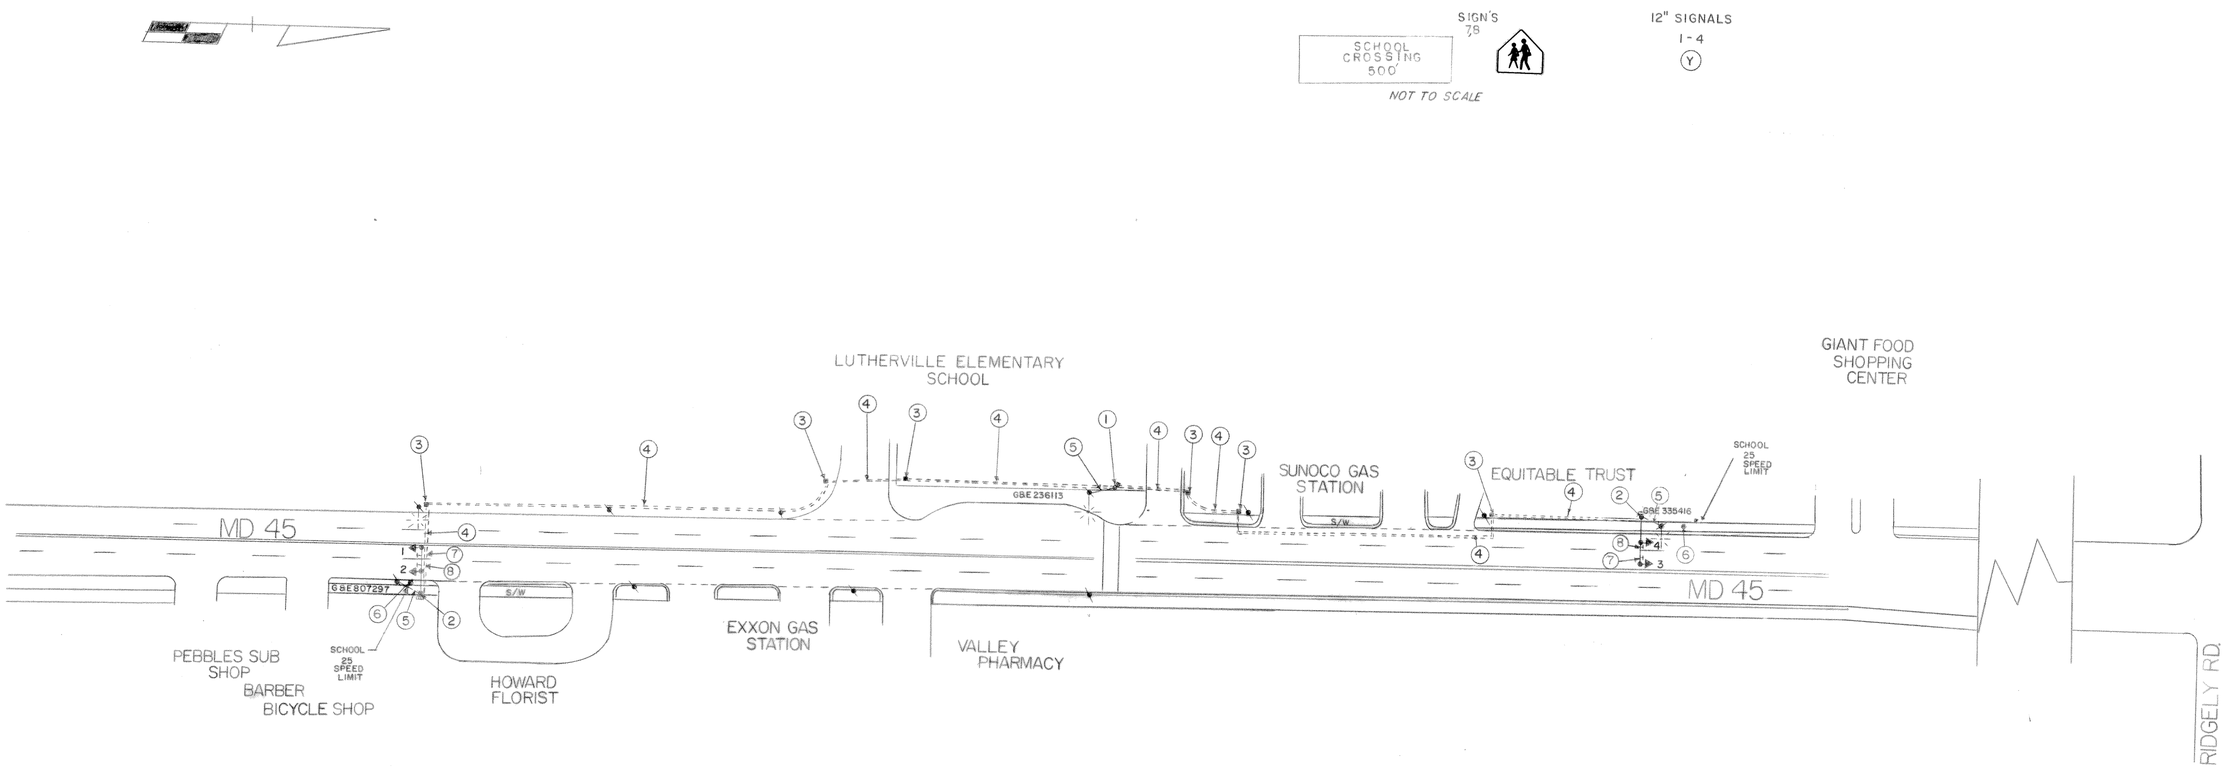

APPROVAL: REGIONAL TRAFFIC ENGINEER 8/26/76

APPROVAL: CHIEF-BUREAU OF TRAFFIC ENGINEERING

APPROVAL: ASS'T. CHIEF ENGINEER TRAFFIC 8/26/76

A 12/8/76
AS BUILT
8-416-452-485
REVISIONS

STATE OF MARYLAND
DEPARTMENT OF TRANSPORTATION
STATE HIGHWAY ADMINISTRATION

TRAFFIC DIVISION – BUREAU OF TRAFFIC ENGINEERING

MD 45 AT LUTHERVILLE ELEMENTARY SCHOOL

SCALE 1"=50' DATE 8/21/76 CONTRACT NO.

DRAWN BY: M. KAPLAN COUNTY: BALTIMORE

DESIGNED BY: SIGNAL NO.:

CHECKED BY:

DRAWING NO. TS-1452

BRUNING 44-511 19927