



BY: \$USERNAME\$

### PHASE CHART

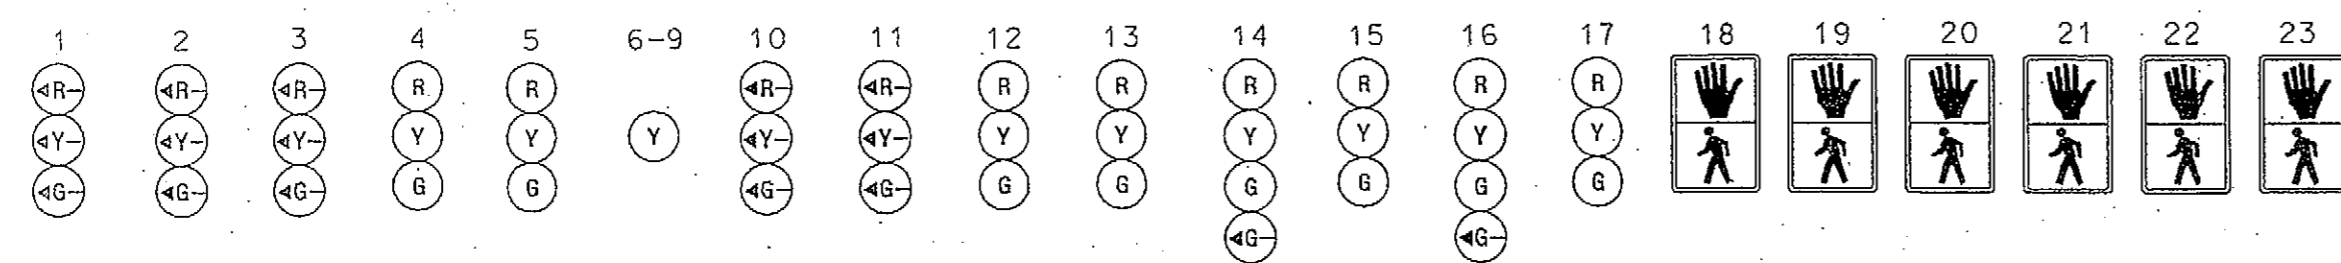

PHASE 1 + 6	←G	←G	←G	G	G	FL/Y	←R	←R	R	R	R	R	R	R	DW	WK	WK	DW	DW	DW	
1 + 6 CHANGE	←Y	←Y	←Y	G	G	FL/Y	←R	←R	R	R	R	R	R	R	DW	WK	WK	DW	DW	DW	
PHASE 2 + 6	←R	←R	←R	G	G	FL/Y	←R	←R	G	G	R	R	R	R	R	WK	FL/DW	FL/DW	WK	DW	DW
PED CLEARANCE	←R	←R	←R	G	G	FL/Y	←R	←R	G	G	R	R	R	R	R	WK	DW	DW	WK	DW	DW
2 + 6 CHANGE	←R	←R	←R	Y	Y	FL/Y	←R	←R	G	G	R	R	R	R	R	WK	DW	DW	WK	DW	DW
PHASE 2 + 5	←R	←R	←R	R	R	FL/Y	←G	←G	G	G	R	R	R	R	R	WK	DW	DW	WK	DW	DW
PED CLEARANCE	←R	←R	←R	R	R	FL/Y	←G	←G	G	G	R	R	R	R	R	WK	DW	DW	WK	DW	DW
2 + 5 CHANGE	←R	←R	←R	R	R	FL/Y	←Y	←Y	Y	Y	R	R	R	R	R	DW	DW	DW	DW	DW	DW
PHASE 3	←R	←R	←R	R	R	FL/Y	←R	←R	R	R	←G	G	R	R	R	DW	DW	DW	DW	DW	DW
3 CHANGE	←R	←R	←R	R	R	FL/Y	←R	←R	R	R	Y	Y	R	R	R	DW	DW	DW	DW	DW	DW
PHASE 4	←R	←R	←R	R	R	FL/Y	←R	←R	R	R	R	R	←G	G	R	DW	DW	DW	DW	DW	DW
4 CHANGE	←R	←R	←R	R	R	FL/Y	←R	←R	R	R	R	R	Y	Y	R	DW	DW	DW	DW	DW	DW
PHASE 4 ALT	←R	←R	←R	R	R	FL/Y	←R	←R	R	R	R	R	←G	G	R	DW	DW	DW	DW	WK	WK
PED CLEARANCE	←R	←R	←R	R	R	FL/Y	←R	←R	R	R	R	R	←G	G	R	DW	DW	DW	DW	FL/DW	FL/DW
4 ALT CHANGE	←R	←R	←R	R	R	FL/Y	←R	←R	R	R	R	R	Y	Y	R	DW	DW	DW	DW	DW	DW
EMERGENCY OPERATION	←R	←R	←R	R	R	FL/Y	←R	←R	R	R	←G	G	R	R	R	DW	DW	DW	DW	DW	DW
FLASHING OPERATION	←FL/R	←FL/R	←FL/R	FL/Y	FL/Y	FL/Y	←FL/R	←FL/R	FL/Y	FL/Y	FL/R	FL/R	FL/R	FL/R	DARK	DARK	DARK	DARK	DARK	DARK	DARK

### WIRING DIAGRAM

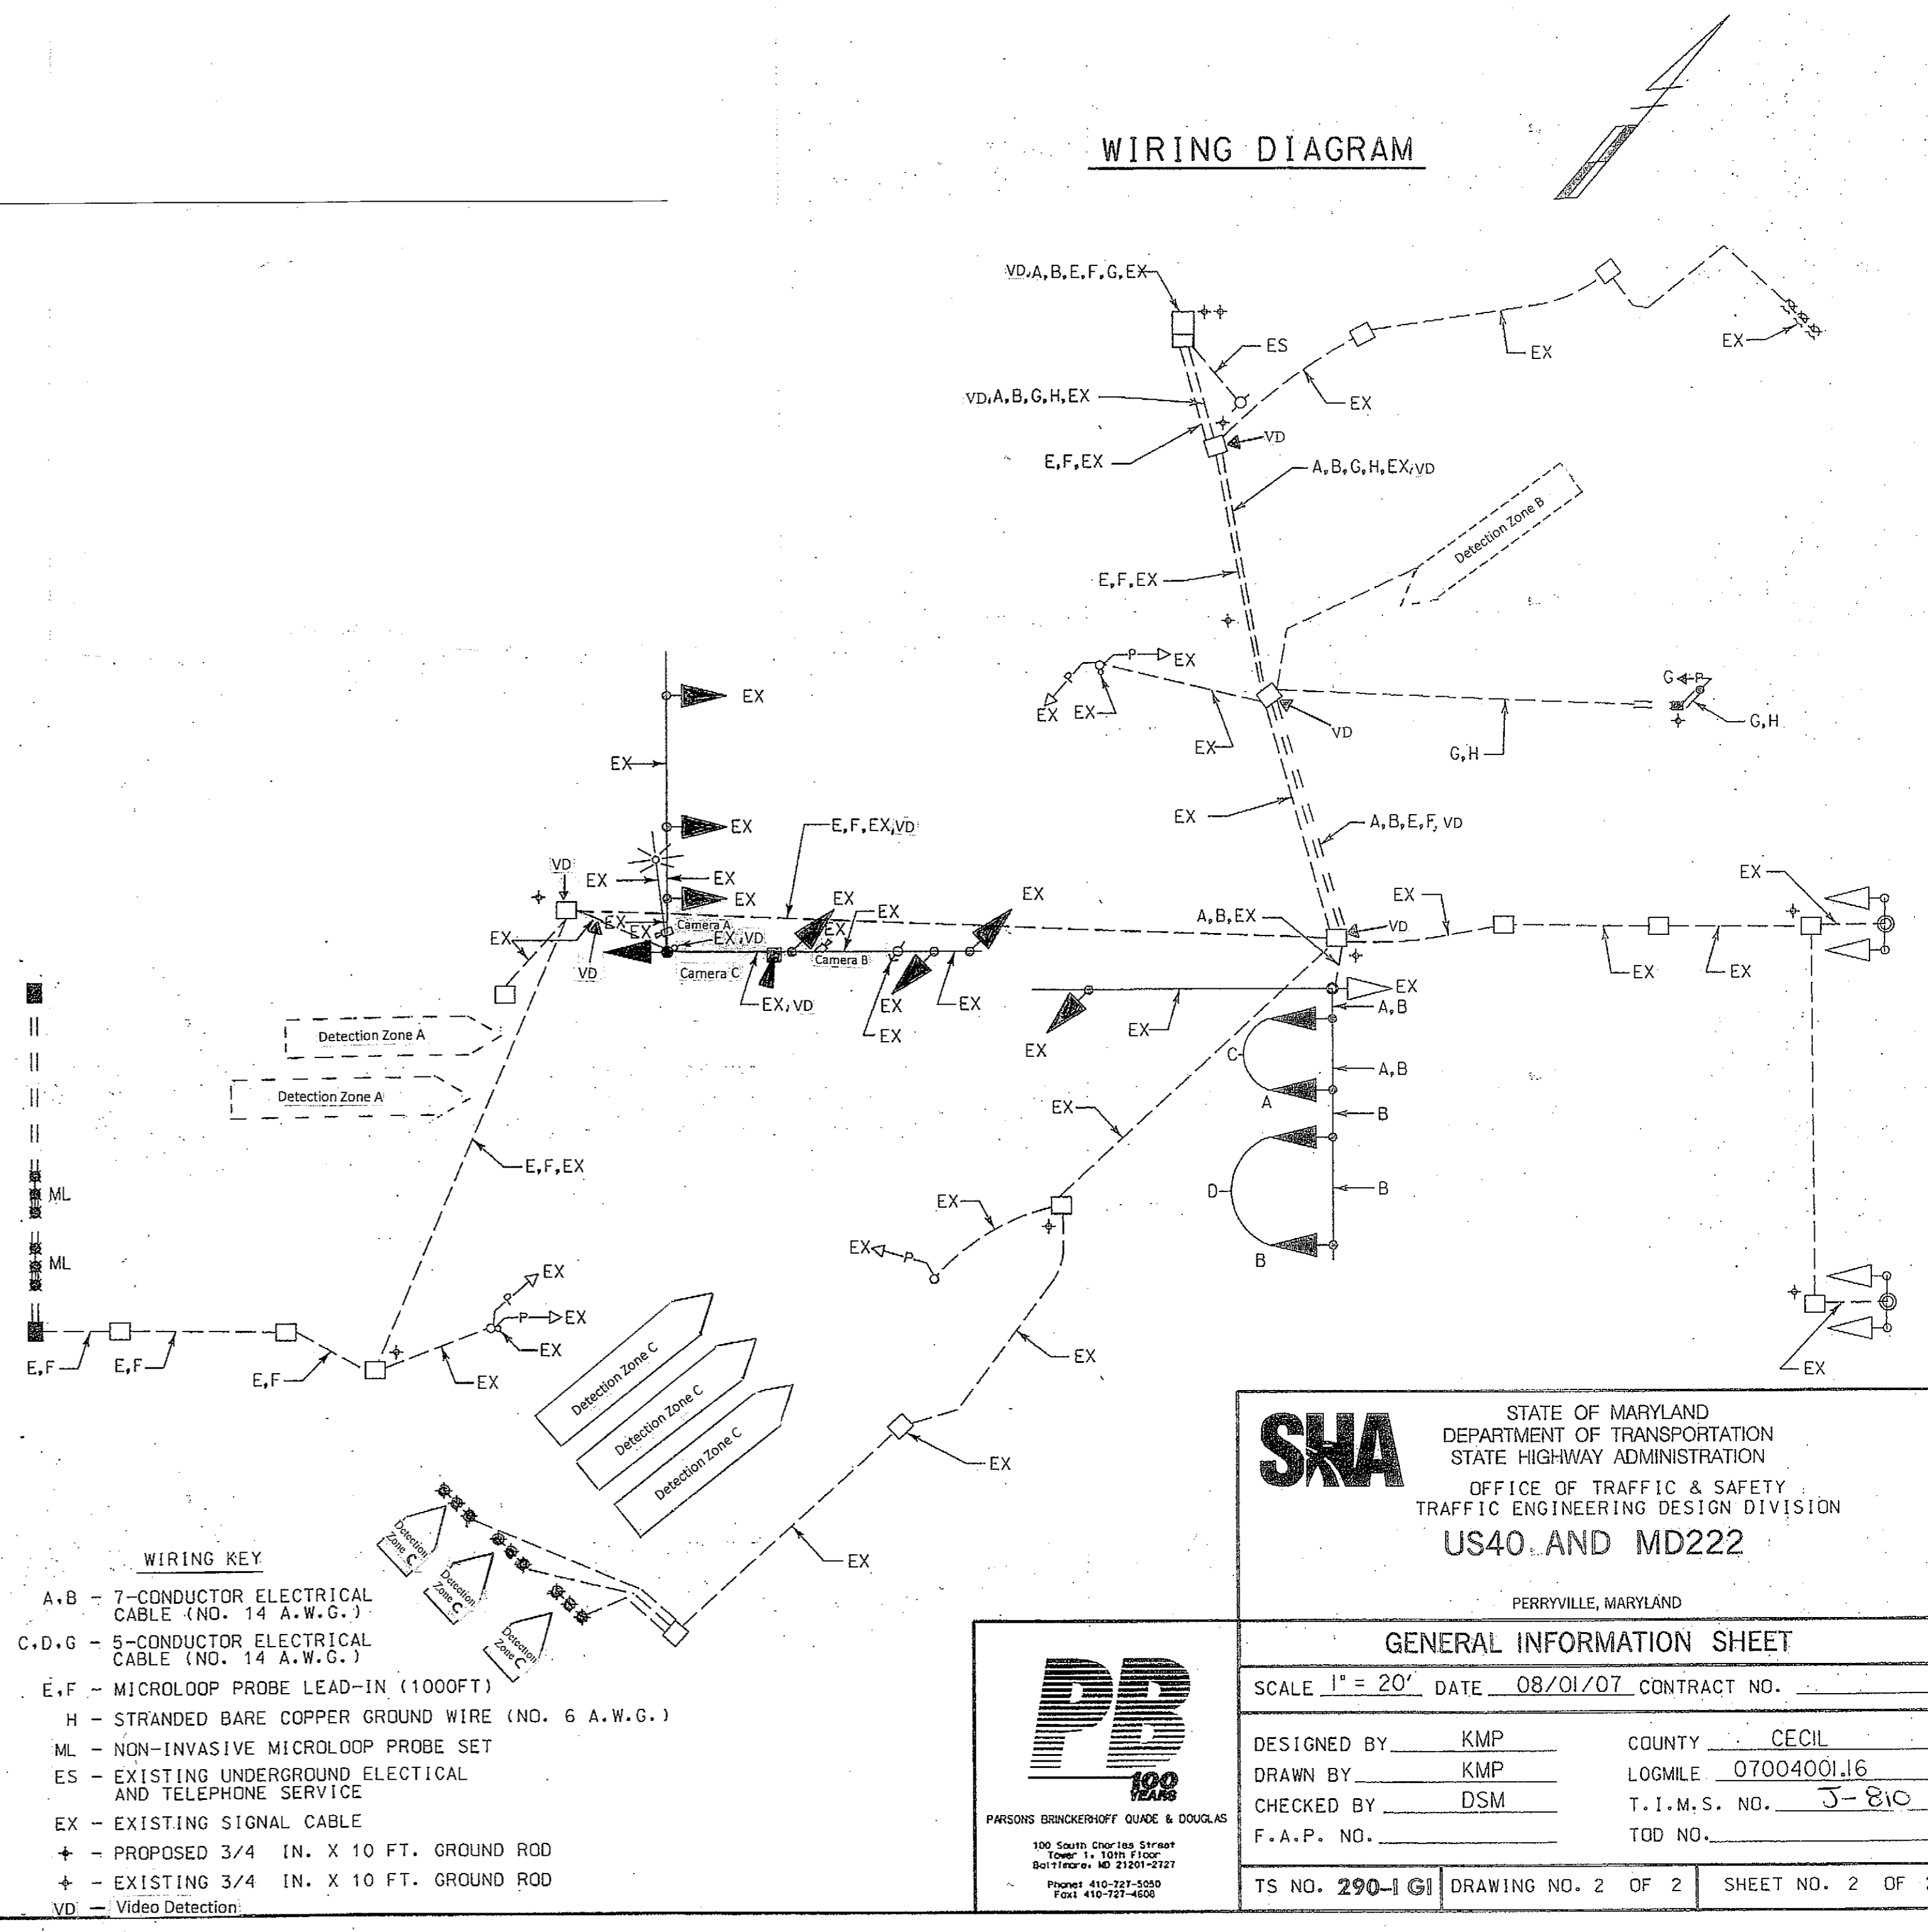

**SHA** STATE OF MARYLAND  
 DEPARTMENT OF TRANSPORTATION  
 STATE HIGHWAY ADMINISTRATION  
 OFFICE OF TRAFFIC & SAFETY  
 TRAFFIC ENGINEERING DESIGN DIVISION  
**US40 AND MD222**  
 PERRYVILLE, MARYLAND

GENERAL INFORMATION SHEET		
SCALE 1" = 20'	DATE 08/01/07	CONTRACT NO.
DESIGNED BY KMP	COUNTY CECIL	
DRAWN BY KMP	LOGMILE 07004001.16	
CHECKED BY DSM	T.I.M.S. NO. J-810	
F.A.P. NO.	TOD NO.	
TS NO. 290-1 G1	DRAWING NO. 2 OF 2	SHEET NO. 2 OF 2

