


CONSTRUCTION NOTES:

- INSTALL HANDHOLE.
- HANDHOLE INSTALLED AS PART OF TRAFFIC SIGNAL.
- INSTALL 3 IN. POLYVINYL CHLORIDE (SCH. 80) ELECTRICAL CONDUIT - TRENCHED.
- INSTALL 2 IN. POLYVINYL CHLORIDE (SCH. 80) ELECTRICAL CONDUIT - TRENCHED.

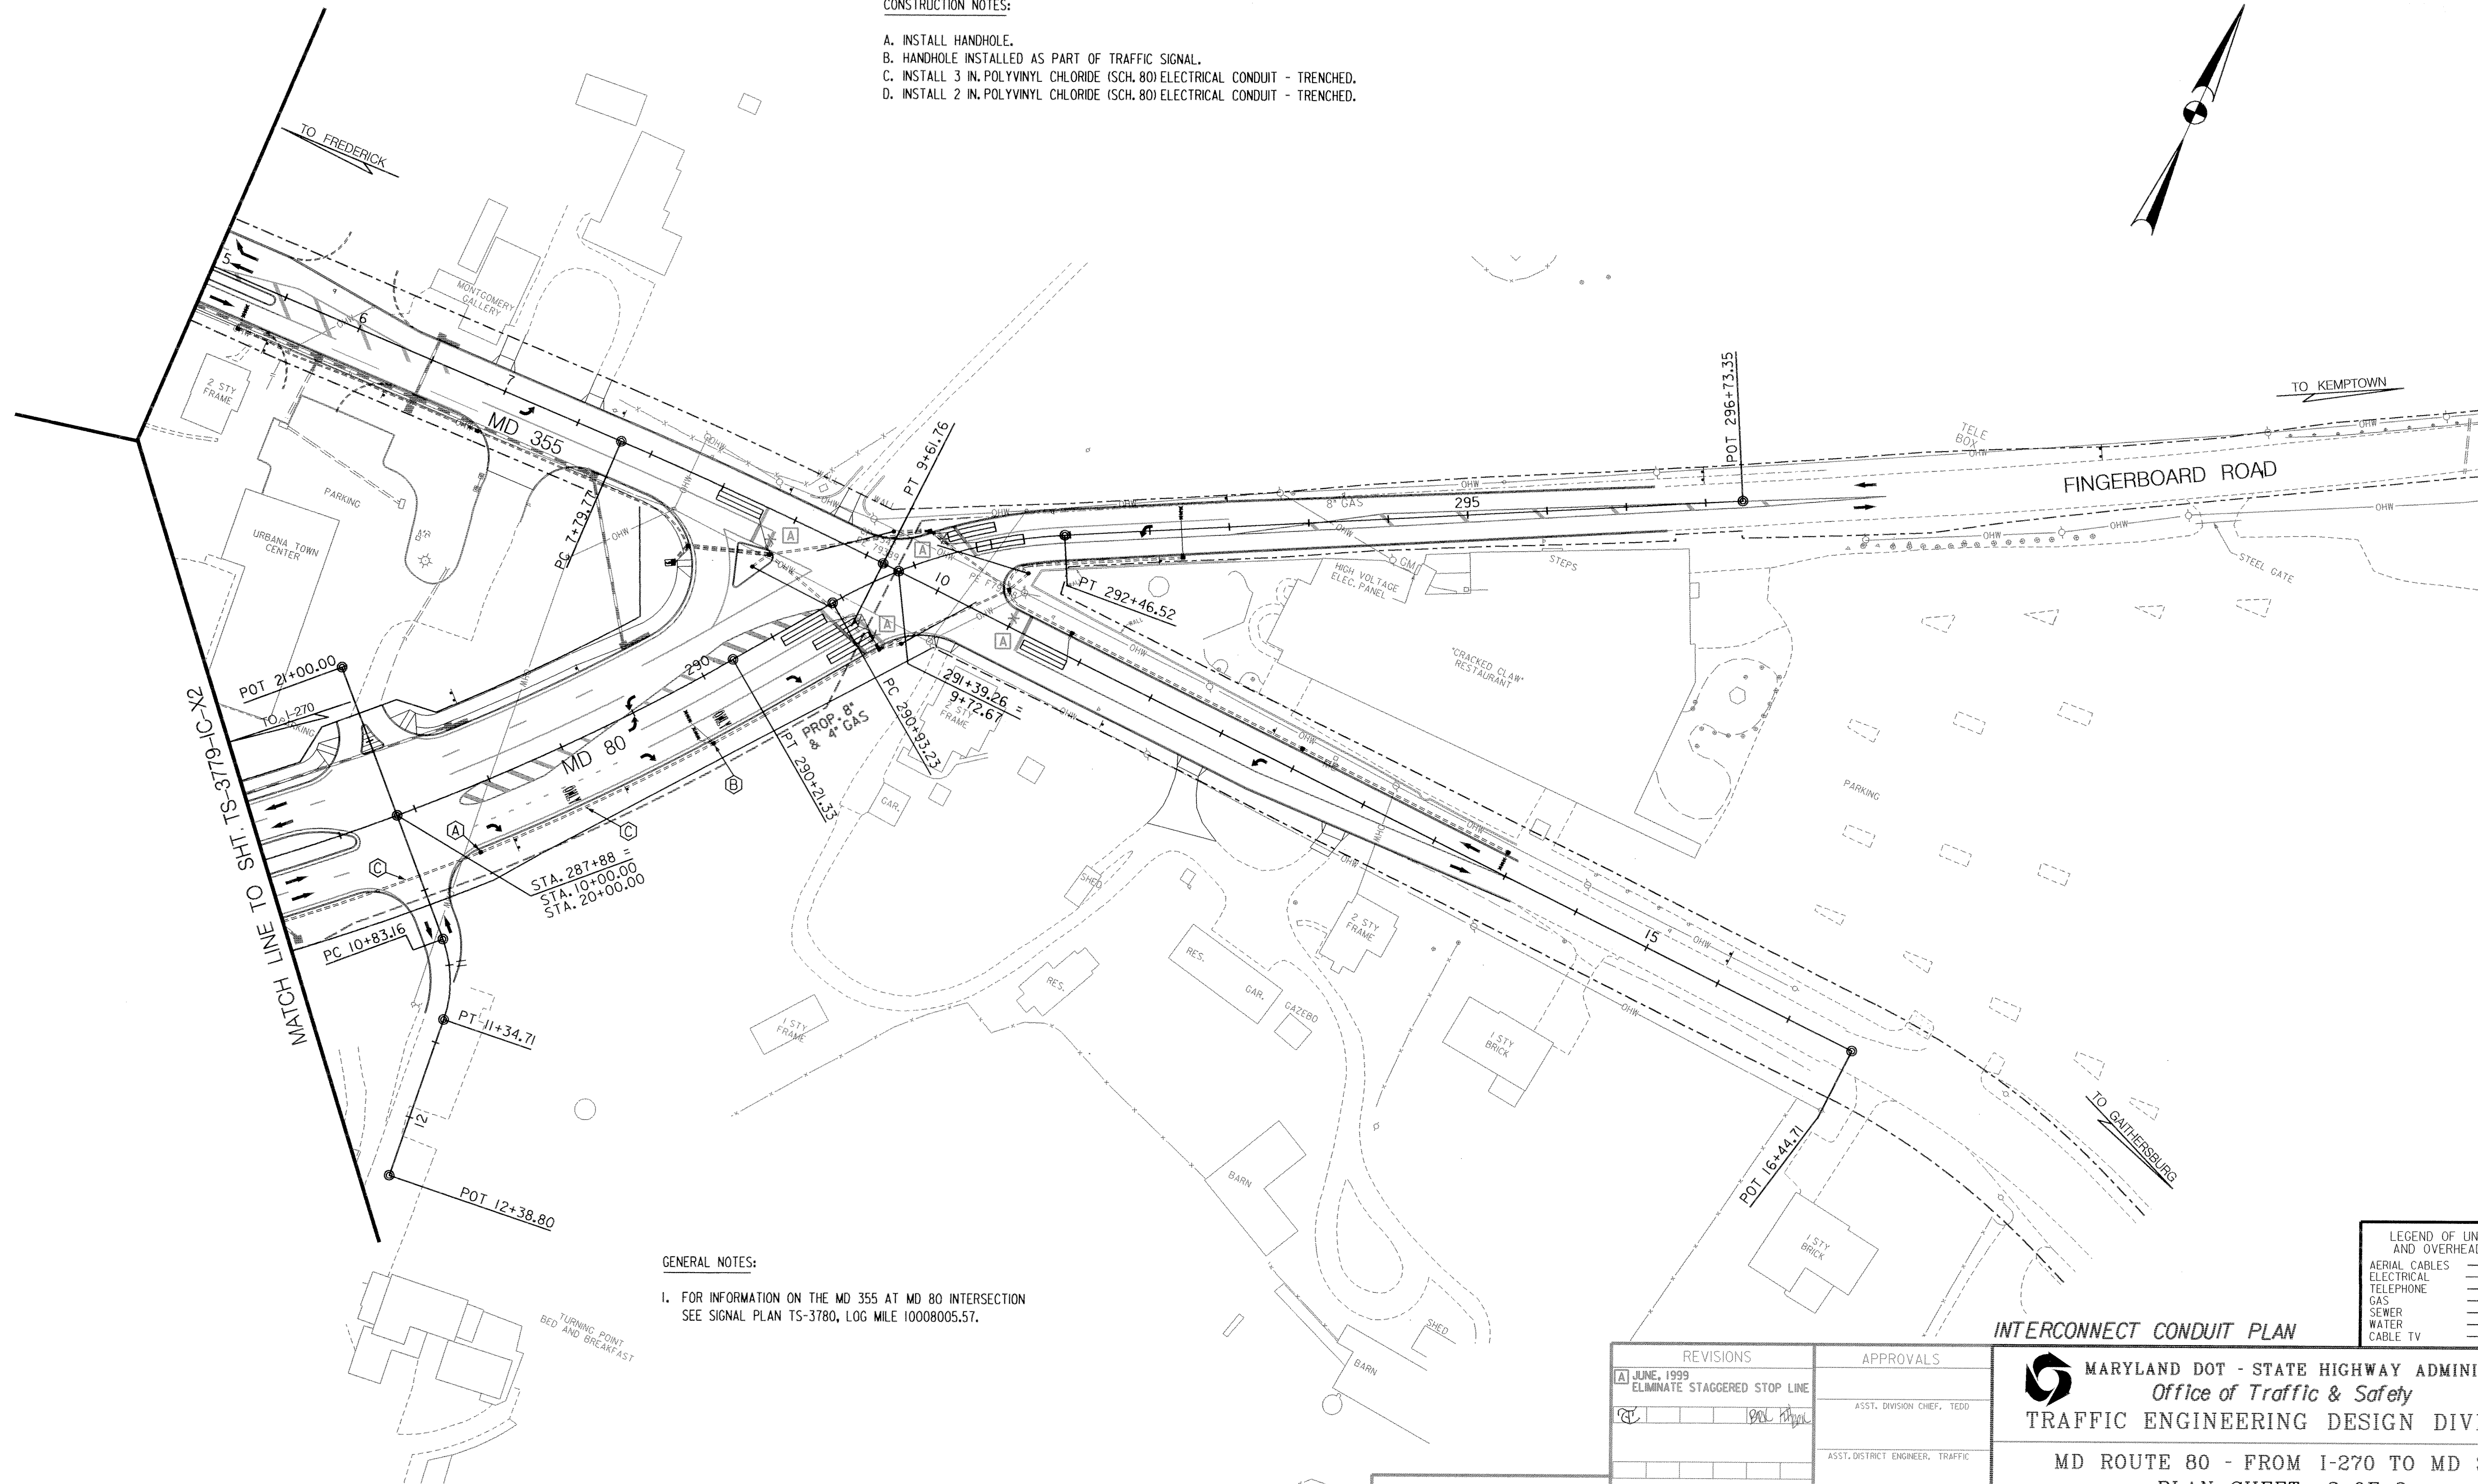

GENERAL NOTES:

- FOR INFORMATION ON THE MD 355 AT MD 80 INTERSECTION SEE SIGNAL PLAN TS-3780, LOG MILE 10008005.57.

| LEGEND OF UNDERGROUND AND OVERHEAD UTILITIES |        |
|----------------------------------------------|--------|
| AERIAL CABLES                                | — A —  |
| ELECTRICAL                                   | — E —  |
| TELEPHONE                                    | — T —  |
| GAS                                          | — G —  |
| SEWER                                        | — S —  |
| WATER                                        | — W —  |
| CABLE TV                                     | — TV — |

INTERCONNECT CONDUIT PLAN

| REVISIONS |                                             | APPROVALS                                  |  |
|-----------|---------------------------------------------|--------------------------------------------|--|
| 1         | JUNE, 1999<br>ELIMINATE STAGGERED STOP LINE | ASST. DIVISION CHIEF, TEDD                 |  |
| 2         |                                             | ASST. DISTRICT ENGINEER, TRAFFIC           |  |
| 3         |                                             | CHIEF, TRAFFIC ENGINEERING DESIGN DIVISION |  |
| 4         |                                             | DIRECTOR, OFFICE OF TRAFFIC & SAFETY       |  |

|   |  |                                                                                                   |  |
|---|--|---------------------------------------------------------------------------------------------------|--|
| <b>MARYLAND DOT - STATE HIGHWAY ADMINISTRATION</b><br>Office of Traffic & Safety<br><b>TRAFFIC ENGINEERING DESIGN DIVISION</b> |  |                                                                                                   |  |
| <b>MD ROUTE 80 - FROM I-270 TO MD 355</b><br><b>PLAN SHEET 3 OF 3</b>                                                          |  |                                                                                                   |  |
| DRAWN BY: <b>JDM</b><br>CHECK BY: <b>JDM</b><br>SCALE: <b>1" = 50'</b>                                                         |  | F.A.P. NO. <b>SEE TITLE SHEET</b><br>S.H.A. NO. <b>SEE TITLE SHEET</b><br>COUNTY <b>FREDERICK</b> |  |
| DATE <b>03/27/98</b>   |  | PLAN SHEET NO.: <b>TS-3779-IC-X3</b><br>SHEET NO.: <b>78</b> OF <b>95</b>                         |  |

THE WILSON T. BALLARD CO.  
CONSULTING ENGINEERS  
OWINGS MILLS, MARYLAND