2/13/02 3:00:47 PM G:\PLOTTING\PS7\OCP\MYLAR_HP.cfg Mcsenay Pierre Division:Transportation m:\1997\0197029\MD28\KEYWEST\SPOIKYUL.prt

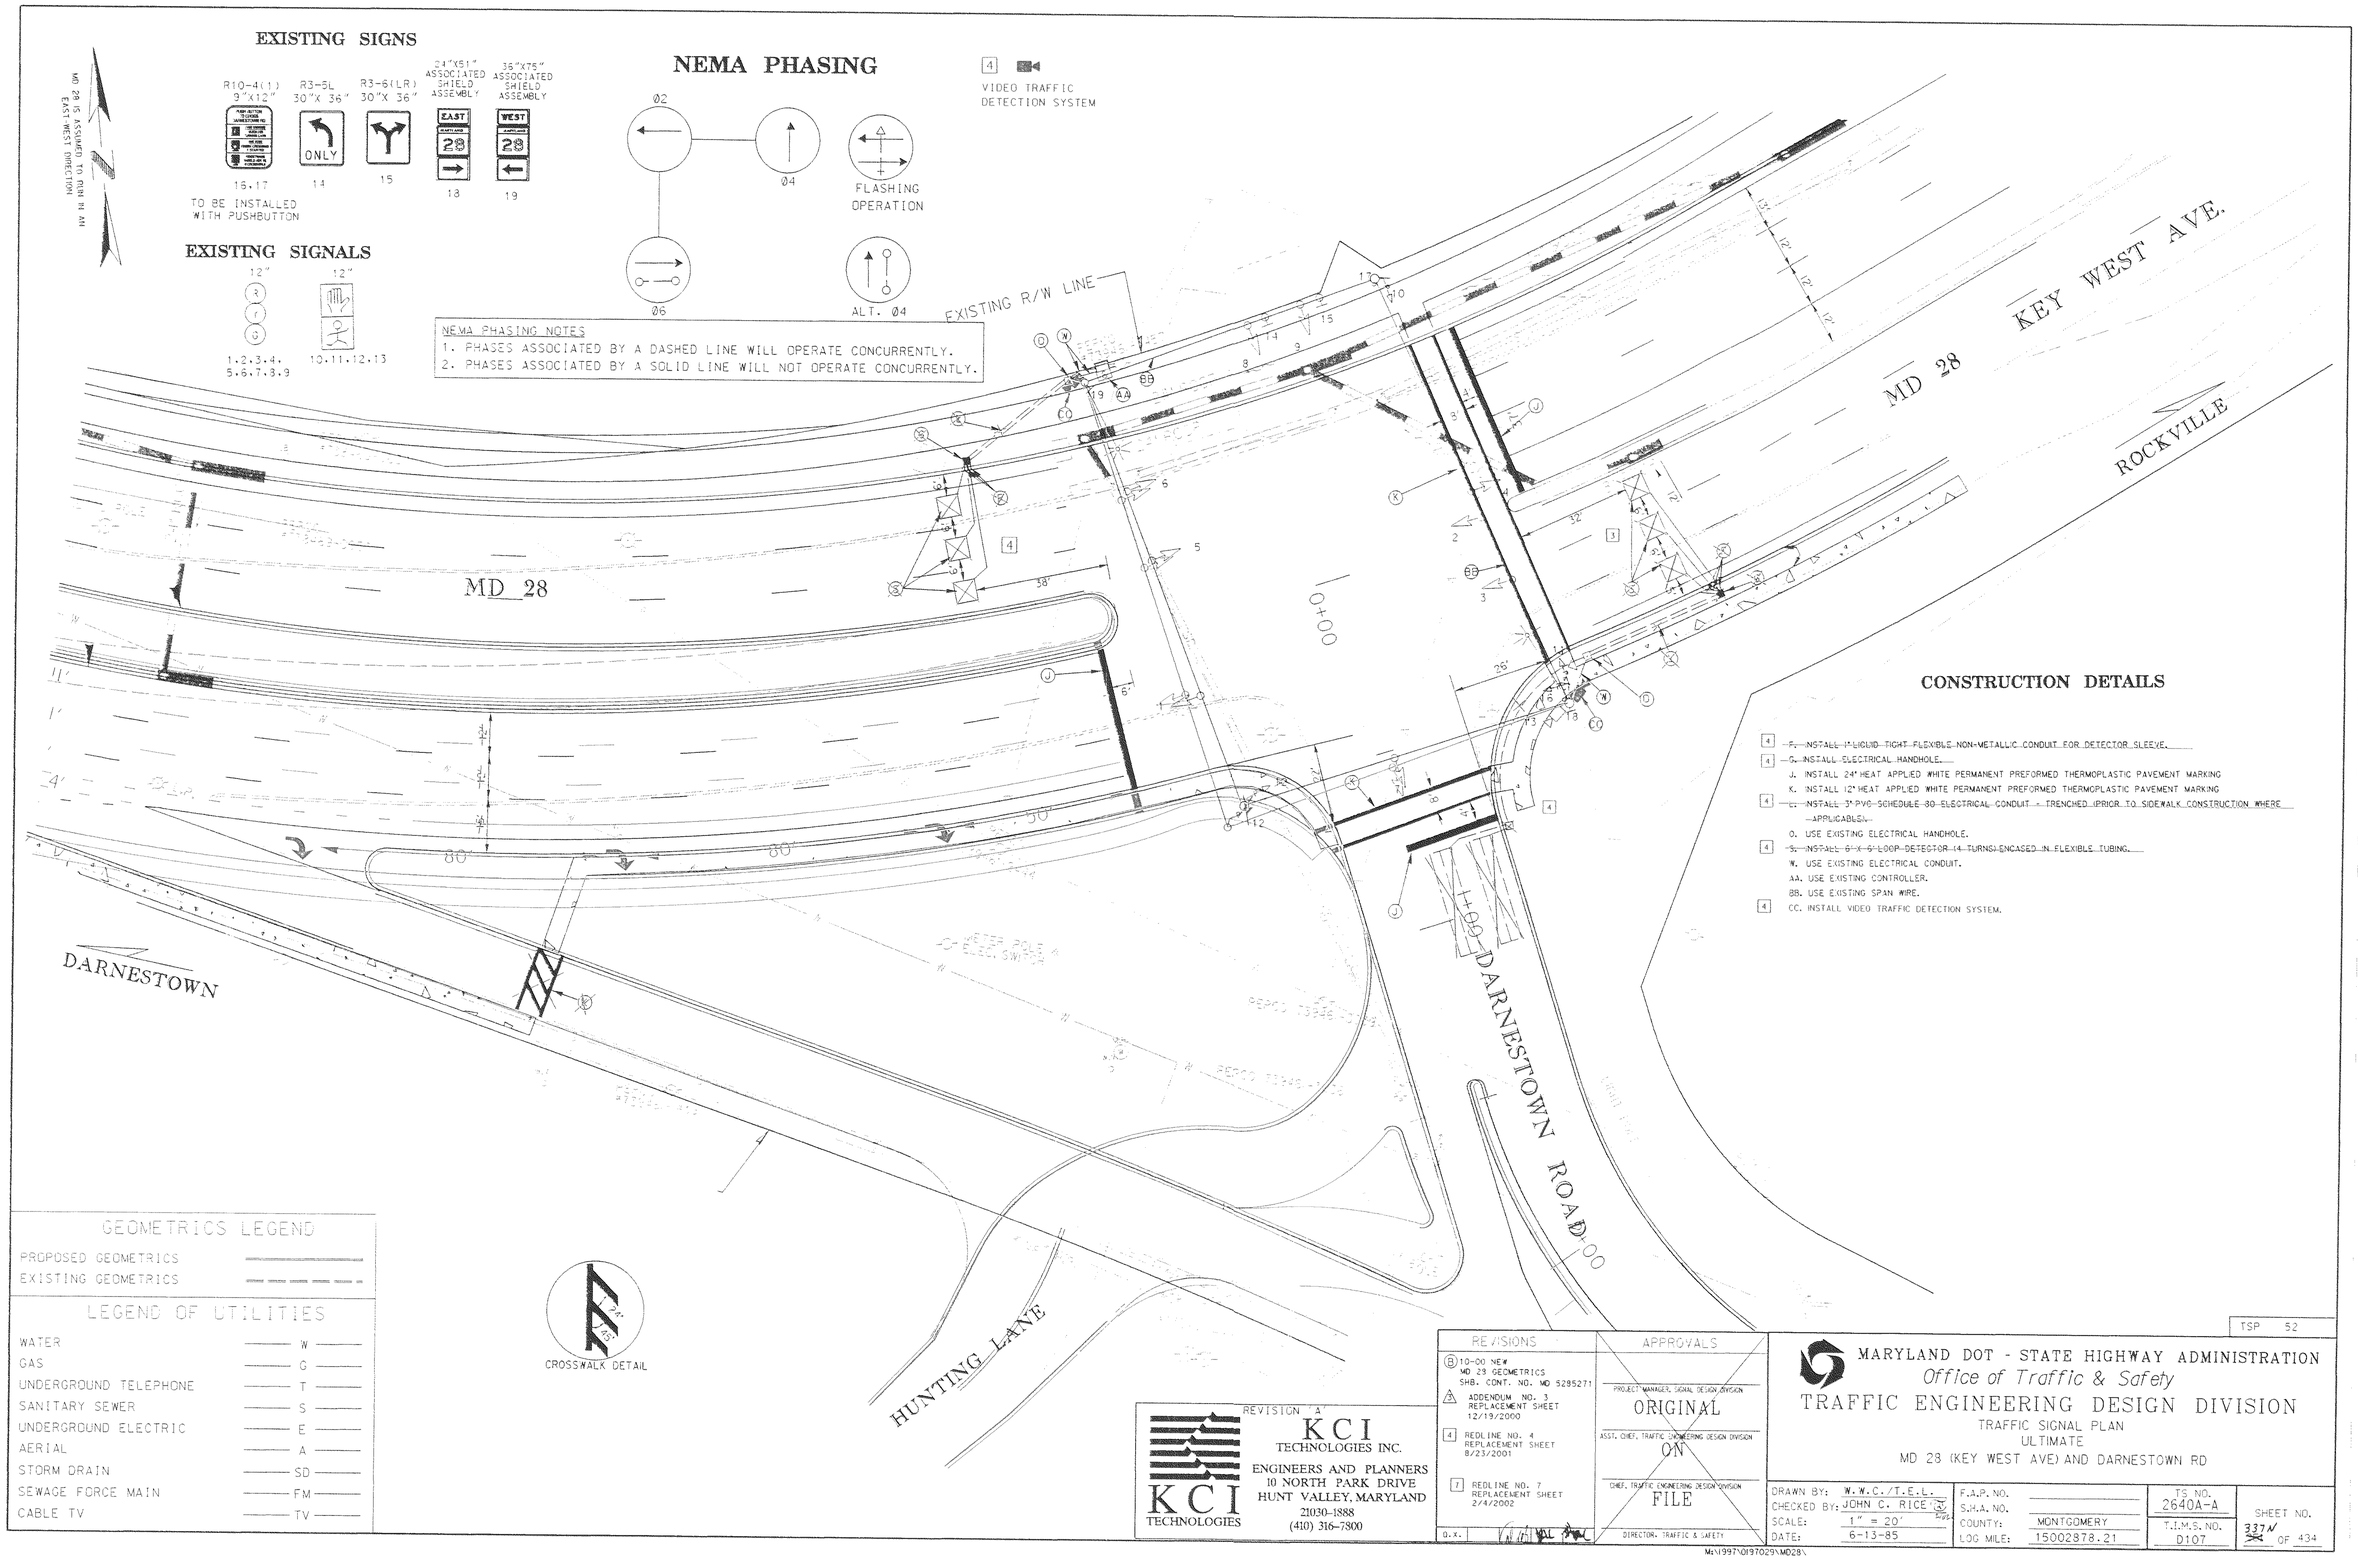


2/13/02 3:00:47 PM G:\PLOTTING\PS7\OCP\MYLAR_HP.cfg Mcsenay Pierre Division:Transportation m:\1997\0197029\MD28\KEYWEST\SPOIKYUL.prt