

STANDARD TYPE A COMBINATION CURB AND GUTTER 12 INCH GUTTER PAN 8 INCH DEPTH SHA STD. NO. MD-220.02	
LOCATION	QUANTITY (LF)
NORTHEAST QUADRANT	67'
SOUTHEAST QUADRANT	70'

DETECTABLE WARNING SURFACE SHA STD. NO. MD-655.40	
LOCATION	QUANTITY (SF)
NORTHEAST QUADRANT	20 SF
SOUTHEAST QUADRANT	22 SF

5 INCH CONCRETE SIDEWALK	
LOCATION	QUANTITY (SF)
NORTHEAST QUADRANT	378 SF
SOUTHEAST QUADRANT	216 SF

RELOCATE PARKING BLOCK	
LOCATION	QUANTITY (EA)
SOUTHEAST QUADRANT	2

NORTHBOUND MD 528

139TH STREET

1 DELETE SHEET IN ENTIRETY.

NOTE: SEE SHEET SG-3 FOR ADDITIONAL
INFORMATION REGARDING PROPOSED
PAVEMENT MARKINGS AND SIGNAL EQUIPMENT

SHA STATE OF MARYLAND
DEPARTMENT OF TRANSPORTATION
STATE HIGHWAY ADMINISTRATION
OFFICE OF TRAFFIC & SAFETY
TRAFFIC ENGINEERING DESIGN DIVISION
MD 528 (COASTAL HIGHWAY) AT 139TH ST.
OCEAN CITY, MD.



RAMP DETAILS

SCALE	1" = 5'	DATE	NOVEMBER 2009	CONTRACT NO.	XX4435185
DESIGNED BY	JDG	COUNTY	WORCESTER		
DRAWN BY	JBB	LOGMILE			
CHECKED BY	ATD	TMS NO.	K186		
FAP NO.		TOD NO.			
TS NO. 2316B-DE	DRAWING	DE-03	OF 3	SHEET NO.	7 OF 7

RK&K
RUMMEL, KLEPPER & KAHL, LLP
81 MOSHER STREET | BALTIMORE, MD 21217
PH: (410) 728-2900 FAX: (410) 728-3160
Engineers | Construction Managers | Planners | Scientists
www.rkk.com

PLOTTED: Monday, May 03, 2010 AT 10:01 AM
FILE: K:\projects\2007\07066_shahdd\Task 06_MD528 Signals\MD 528 at 139th\CADD\plan\pDE-002_139th.dgn

- LEGEND**
- CONCRETE PAVEMENT
 - DETECTABLE WARNING SURFACE

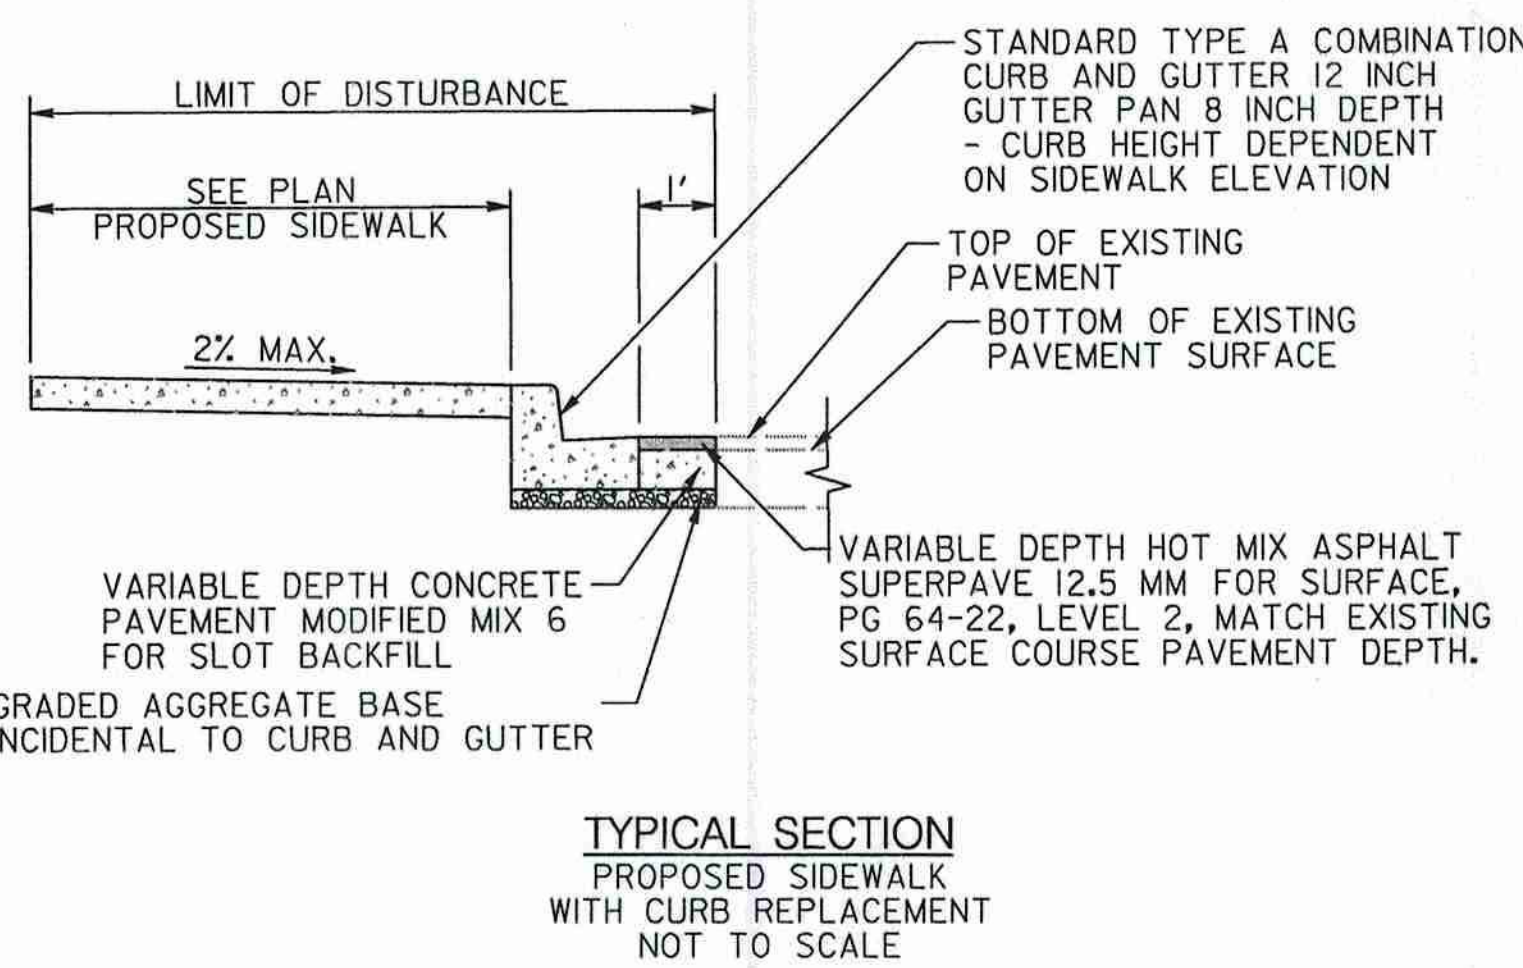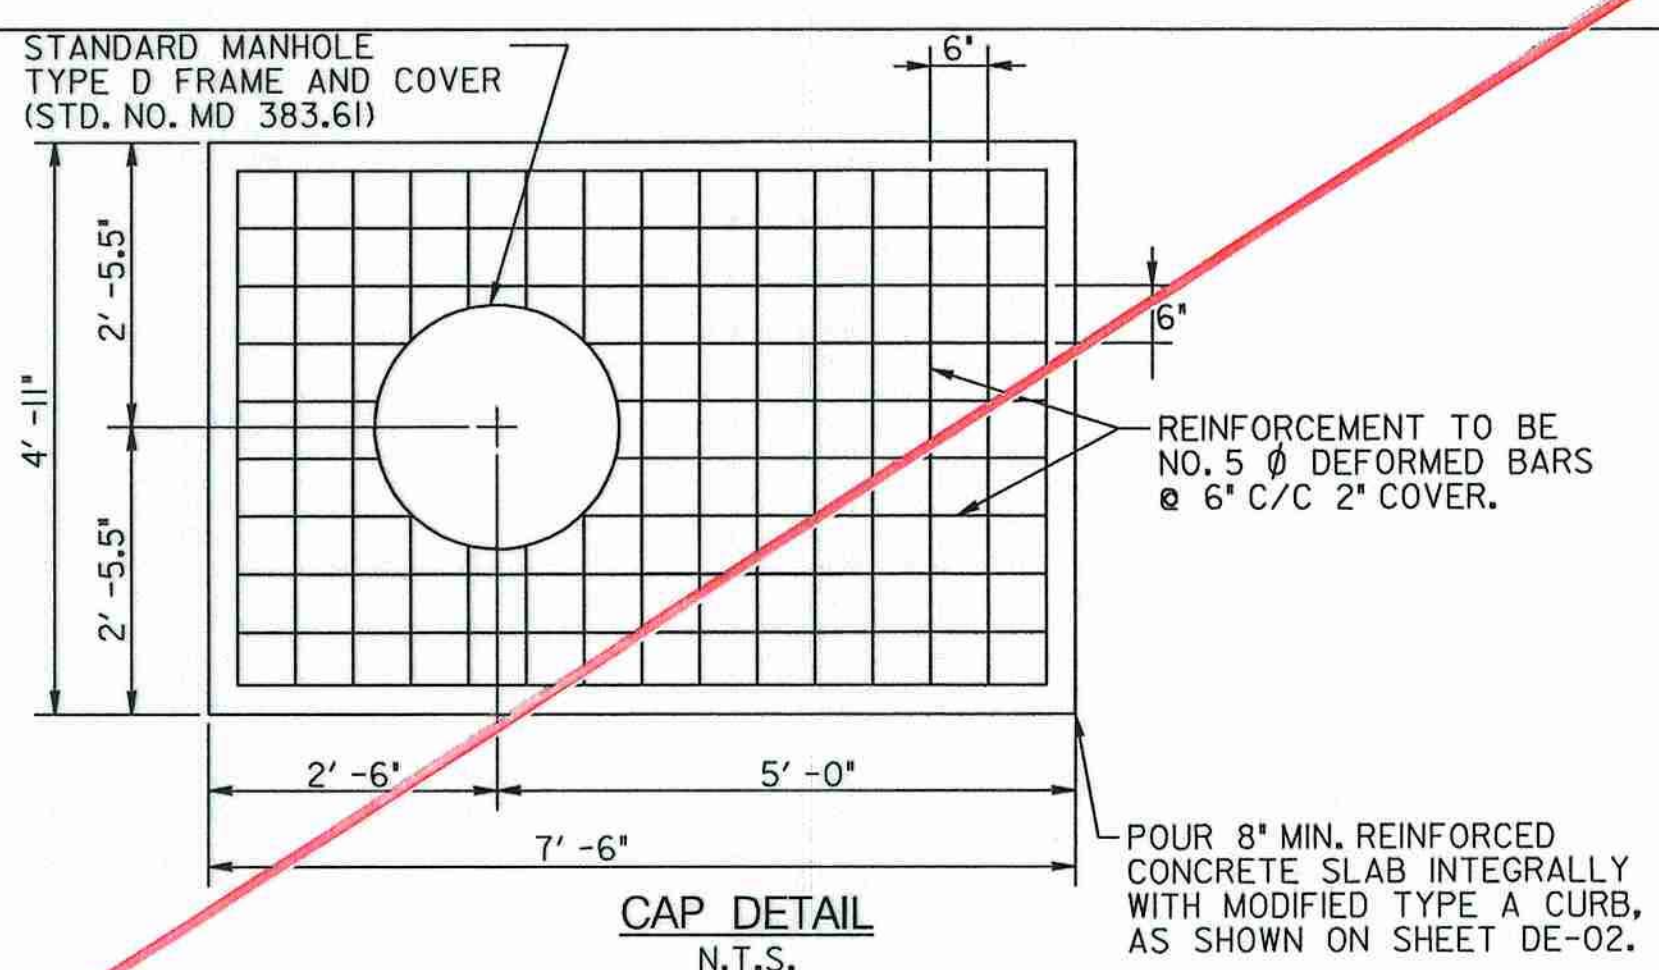

BY: wwiesmantel